



Wisconsin Department of Transportation

Division of Transportation Systems Development

Bureau of Project Development
4822 Madison Yards Way, 4th Floor South
Madison, WI 53705

January 23, 2023

Telephone: (608) 266-1631
Facsimile (FAX): (608) 266-8459

NOTICE TO ALL CONTRACTORS:

Proposal #07: 5130-05-63, WISC 2023238
Ontario - Tomah
STH 71 - CTH A/B-41-21,-136,-137
STH 131
Monroe County

Letting of February 14, 2023

This is Addendum No. 01, which provides for the following:

Special Provisions:

Added Special Provisions	
Article No.	Description
31	Replacing Guardrail Posts and Blocks – EAT, Item SPV.0060.05

Schedule of Items:

Revised Bid Item Quantities					
Bid Item	Item Description	Unit	Proposal Total Prior to Addendum	Proposal Quantity Change (-)	Proposal Total After Addendum
614.0950	Replacing Guardrail Posts and Blocks	EACH	94	-48	46

Added Bid Item Quantities					
Bid Item	Item Description	Unit	Proposal Total Prior to Addendum	Quantity Added	Proposal Total After Addendum
SPV.0060.05	Replacing Guardrail Posts and Blocks – EAT	EACH	0	48	48

Plan Sheets:

Revised Plan Sheets	
Plan Sheet	Plan Sheet Title (brief description of changes to sheet)
28	Miscellaneous Quantities (revised and added item quantities to Beam Guard Summary)
32	Plan (revised item name in callouts)
33	Plan (revised item name in callouts)
34	Plan (revised item name in callouts)
35	Plan (revised item name in callouts)
36	Plan (revised item name in callouts)
38	Plan (revised item name in callouts)
39	Plan (revised item name in callouts)

The responsibility for notifying potential subcontractors and suppliers of these changes remains with the prime contractor.

Sincerely,

Mike Coleman

Proposal Development Specialist
Proposal Management Section

ADDENDUM NO. 01

5130-05-63

January 23, 2023

Special Provisions

31. Replacing Guardrail Posts and Blocks - EAT, Item SPV.0060.05.

A Description

This special provision describes providing describes replacing unserviceable posts and blocks for existing energy absorbing terminal guardrail installations

B Materials

Furnish wood posts and offset blocks conforming to standard spec 507.2 and 614.2.5.1.

C Construction

Replace posts and offset blocks conforming to standard spec 614.3.1, 614.3.2.1, and 614.3.8.

D Measurement

The department will measure Replacing Guardrail Posts and Blocks - EAT by the each individual post location, acceptably completed.

E Payment

The department will pay for measured quantities at the contract unit price under the following bid item:

ITEM NUMBER	DESCRIPTION	UNIT
SPV.0060.05	Replacing Guardrail Posts and Blocks – EAT	EACH

Payment is full compensation for replacing posts and blocks, and for excavating and backfilling.

Schedule of Items

Attached, dated January 23, 2023, are the revised Schedule of Items Pages 4 and 8.

Plan Sheets

The following 8½ x 11-inch sheets are attached and made part of the plans for this proposal:


Revised: 28, 32, 33, 34, 35, 36, 38, and 39.

END OF ADDENDUM

Addendum No. 01
ID 5130-05-63
Revised Sheet 32
January 23, 2023




BEGIN PROJECT
 STA 100+00
 STA 109+110
 Y = 715,258.466
 X = 715,258.466
 MATCH EXISTING
 REMOVING ASPHALTIC
 SURFACE BUTT JOINTS

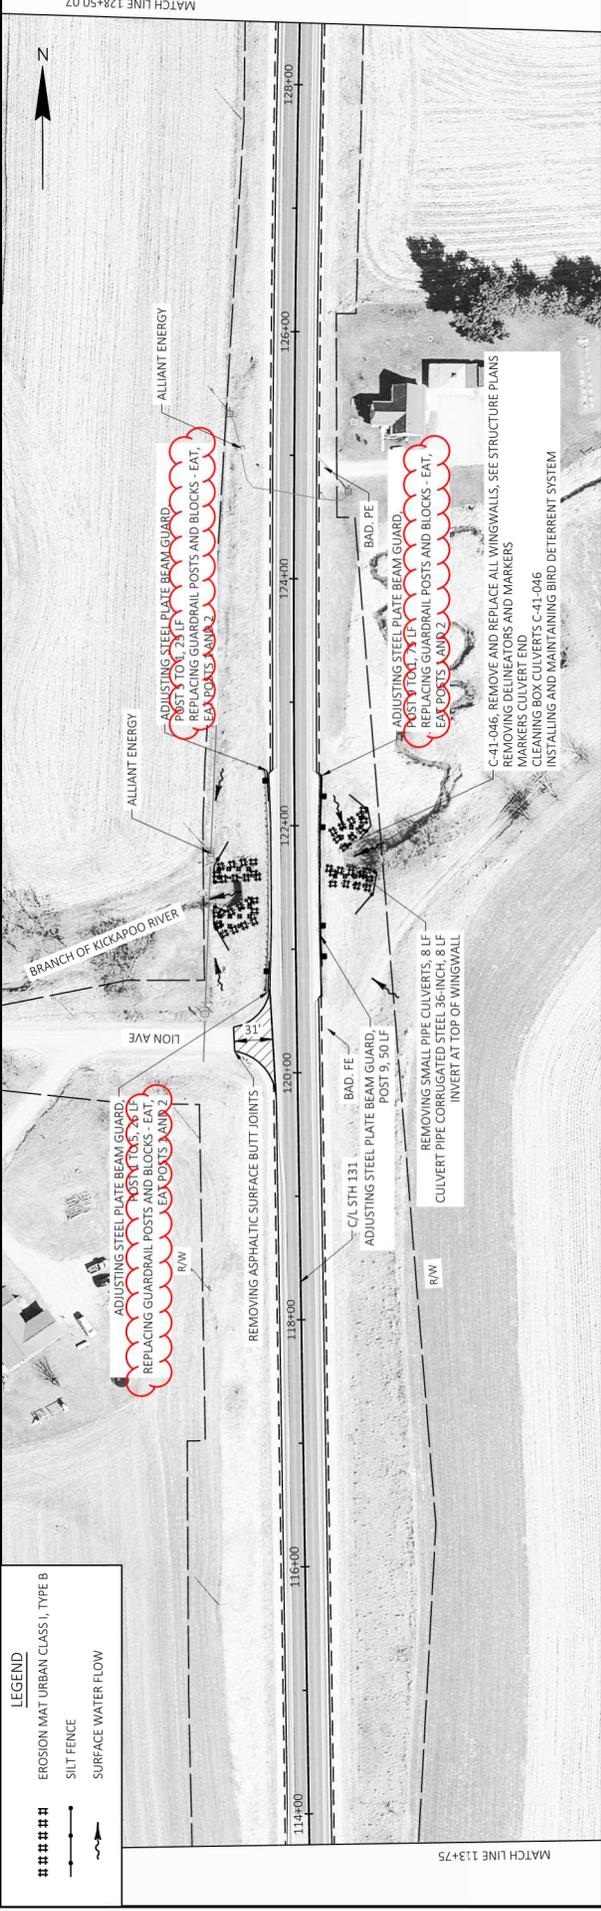

C-41-046 REMOVE AND REPLACE ALL WINGWALLS, SEE STRUCTURE PLANS
 REMOVING DELINEATORS AND MARKERS
 CLEANING BOX CULVERTS C-41-046
 INSTALLING AND MAINTAINING BIRD DETERRENT SYSTEM



Addendum No. 01
 ID 5130-05-63
 Revised Sheet 33
 January 23, 2023

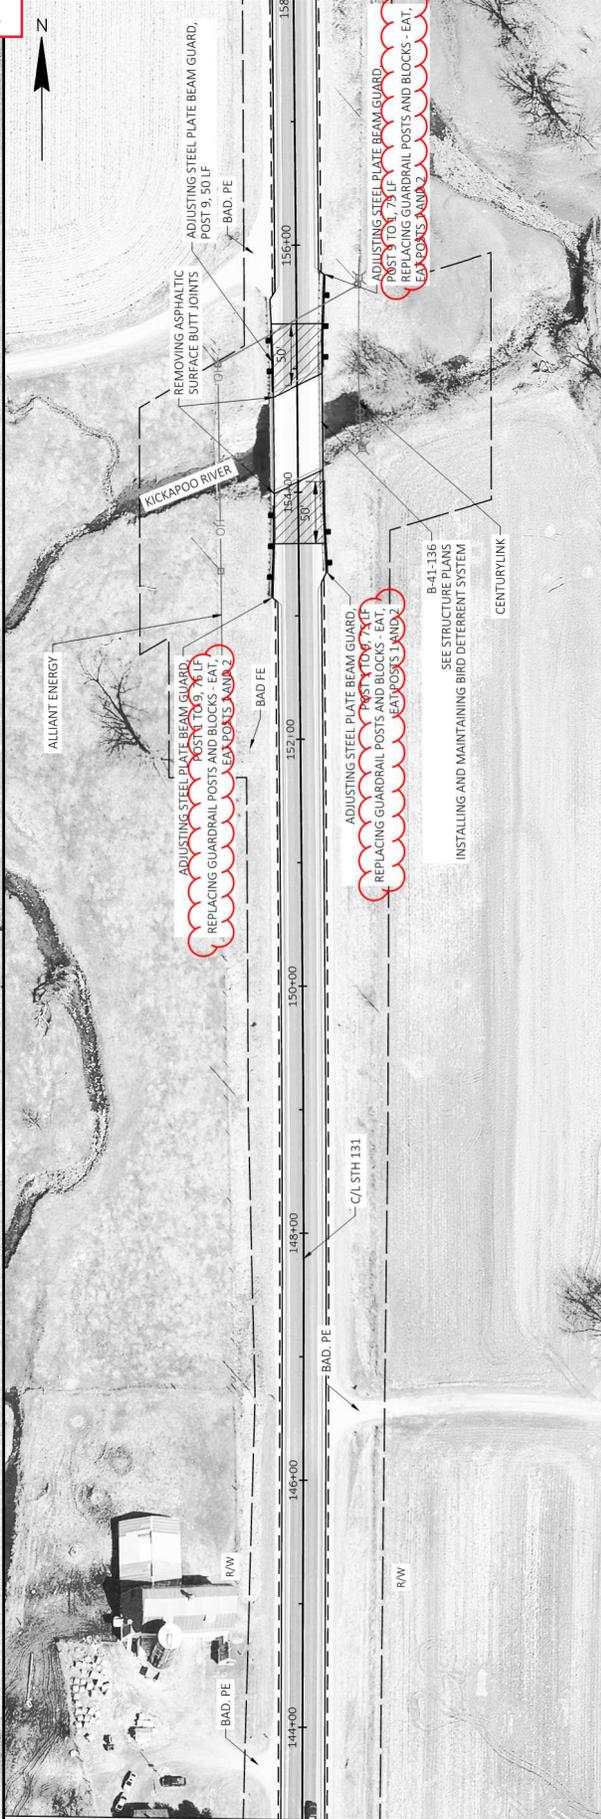

ADJUSTING STEEL PLATE BEAM GUARD
 POST TO 6' 7 1/2 LF
 REPLACING GUARDRAIL POSTS AND BLOCKS - EAT,
 EAT VOS'S 1 AND 2

ADJUSTING STEEL PLATE BEAM GUARD
 POST TO 9' 50 LF
 REPLACING GUARDRAIL POSTS AND BLOCKS - EAT,
 EAT VOS'S 1 AND 2

B-41-136
 SEE STRUCTURE PLANS
 INSTALLING AND MAINTAINING BIRD DETERRENT SYSTEM
 CENTURYLINK



PROJECT NO: 5130-05-63	COUNTY: MONROE	PLAN	SHEET 33	E
FILE NAME: W:\51300563\CADD\5130SHEETS\PLAN\50201-P\LDWG	DATE: 1/23/2023 9:39 AM	PLOT BY: CORONA WOYCHIK	PLOT SCALE: 1 IN=100 FT	PLOT NAME: W5007CADD5 SHEET 44
LAAYOUT NAME: 05-63				



Addendum No. 01
 ID 5130-05-63
 Revised Sheet 34
 January 23, 2023


PROJECT NO: 5130-05-63	COUNTY: MONROE	PLAN	SHEET 34	E
FILE NAME: W:\31300563\CADD\SHETS\PLAN\5130-05-63-PLNDWG	DATE: 1/23/2023 9:39 AM	PLOT BY: CORONA WOYCHIK	PLOT SCALE: 1 IN=100 FT	WISDOT/CADD/SHEET 44
PROJECT NAME: HWY: STH 131				

Addendum No. 01
 ID 5130-05-63
 Revised Sheet 35
 January 23, 2023

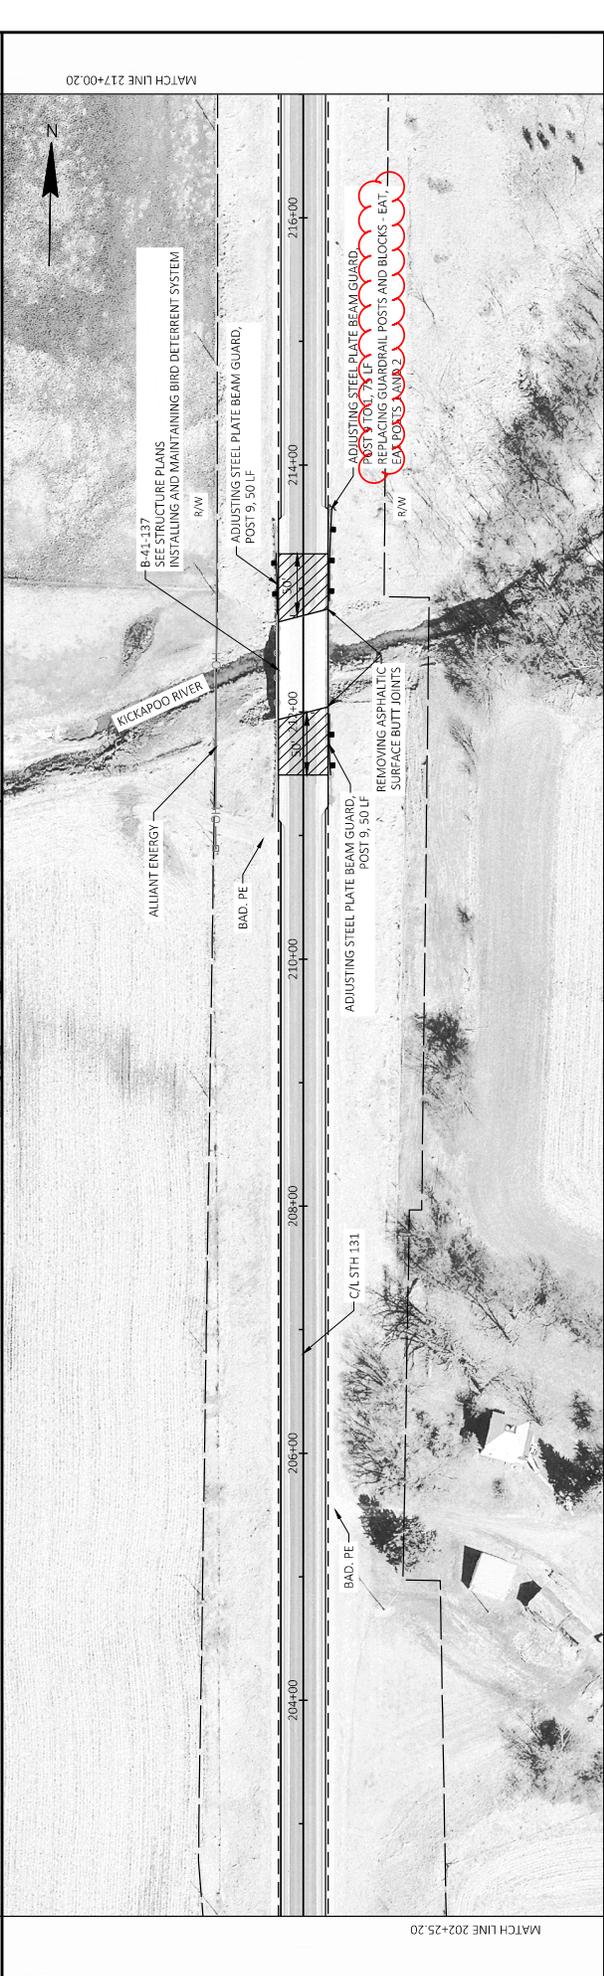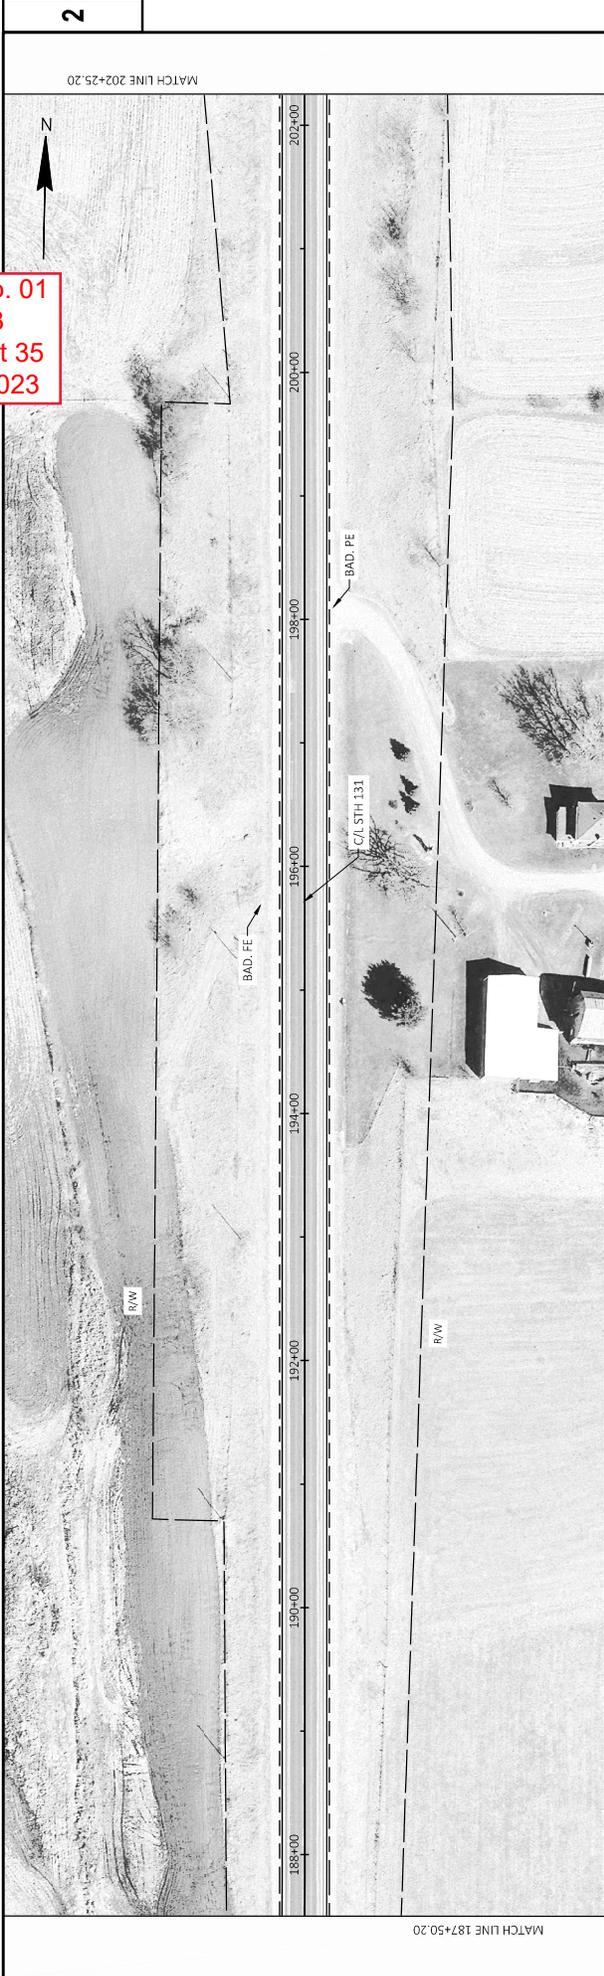

PROJECT NO: 5130-05-63	COUNTY: MONROE	PLAN	SHEET 35
FILE NAME: W:\51300563\CD\SHSHEETS\PLAN\050202-PN.DWG	PLLOT BY: CORDINA WOYCHIK	PLLOT NAME:	W:\51300563\SHSHEET 44
LAYOUT NAME: 04-pp	PLLOT DATE: 1/13/2023 9:40 AM	PLLOT SCALE: 1"=100 FT	
HWY: STH 131			

Addendum No. 01
 ID 5130-05-63
 Revised Sheet 38
 January 23, 2023

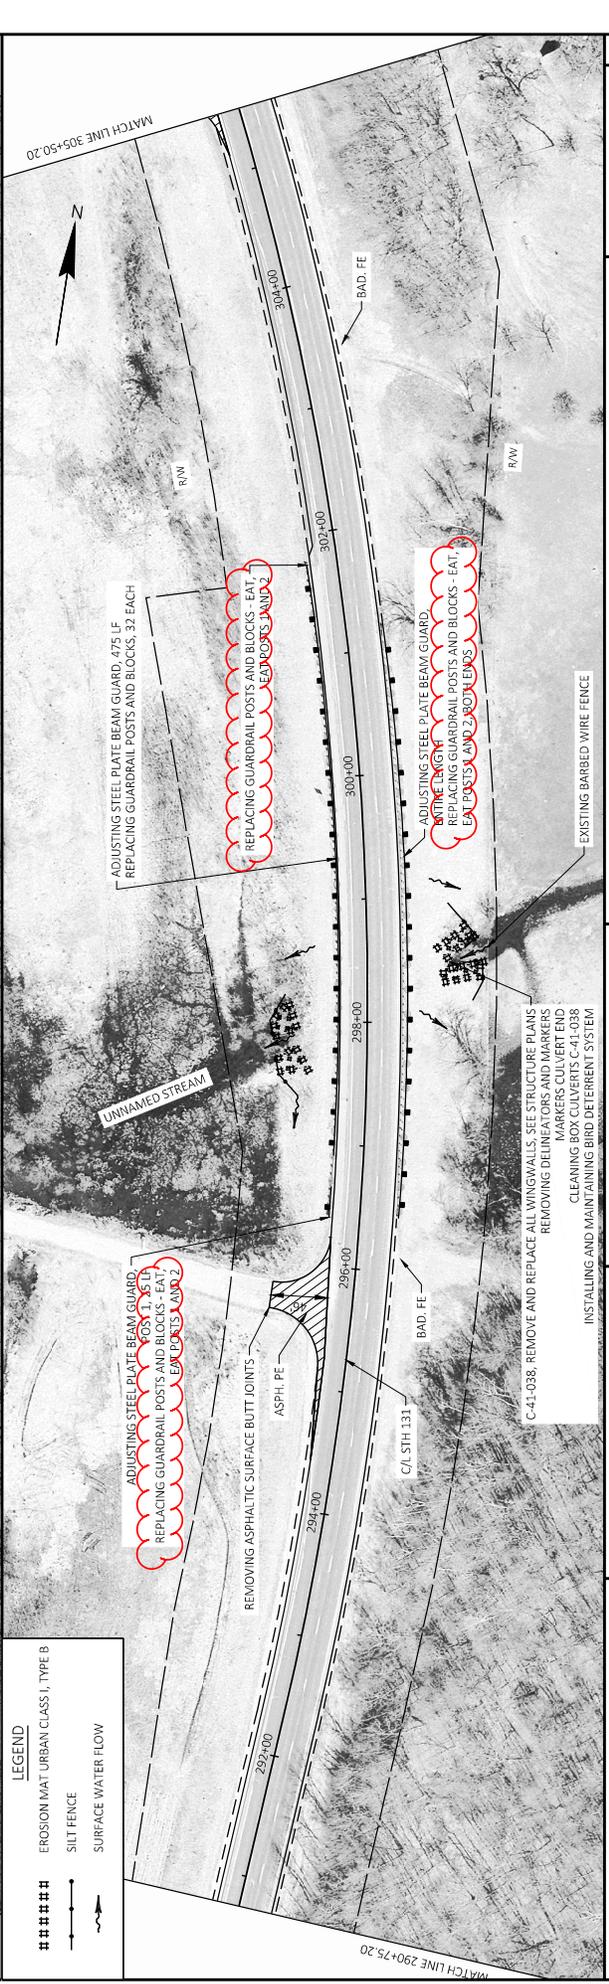

LEGEND

- ##### EROSION MAT URBAN CLASS II, TYPE B
- SILT FENCE
- SURFACE WATER FLOW


ADJUSTING STEEL PLATE BEAM GUARD,
 REPLACING GUARDRAIL POSTS AND BLOCKS - EAT,
 EX POSTS AND ?

ADJUSTING STEEL PLATE BEAM GUARD, 475 LF
 REPLACING GUARDRAIL POSTS AND BLOCKS, 32 EACH
 REPLACING GUARDRAIL POSTS AND BLOCKS - EAT,
 EX POSTS AND ?

ADJUSTING STEEL PLATE BEAM GUARD,
 REPLACING GUARDRAIL POSTS AND BLOCKS - EAT,
 EX POSTS AND ?

C-41-038, REMOVE AND REPLACE ALL WINGWALLS, SEE STRUCTURE PLANS
 REMOVE DELINEATORS AND MARKERS
 CLEANING ROAD COLLLECT FOR
 INSTALLING AND MAINTAINING BIRD DETERRENT SYSTEM

PROJECT NO: 5130-05-63	COUNTY: MONROE	PLAN	SHEET 38	E
FILE NAME: W:\51300563\CADD\SHEETS\PLAN\050202-P\LDWG	PLLOT DATE: 1/13/2023 9:42 AM	PLLOT BY: CORDINA WOYCHIK	PLLOT SCALE: 1 IN=100 FT	WIS007CADD05 SHEET 44
LAYOUT NAME: 07-99				

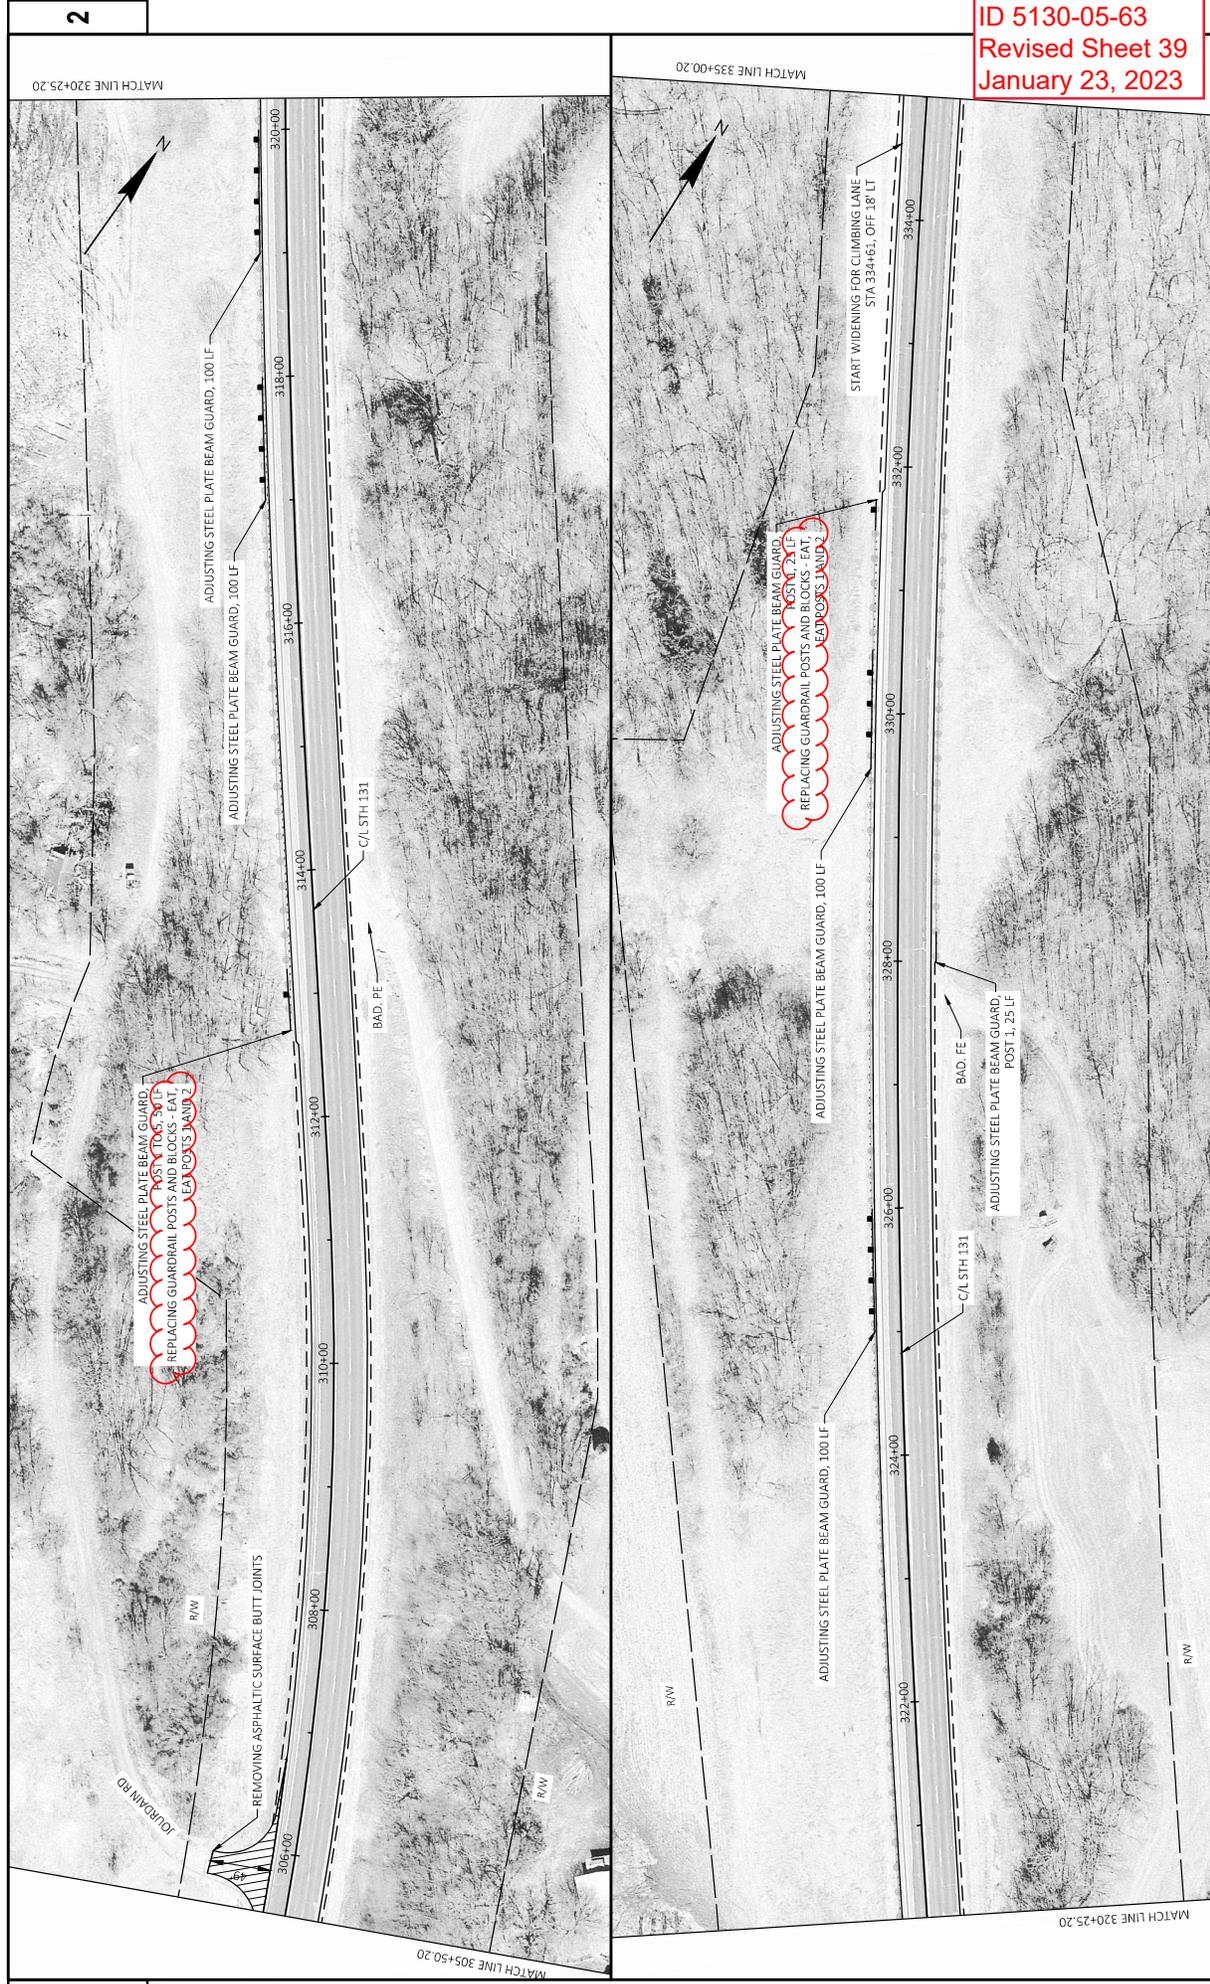

2

2

PROJECT NO: 5130-05-63	COUNTY: MONROE	PLAN	SHEET 39	E
FILE NAME: W:\51300563\CADD\SHEET\PLAN\05020-P\LDWG LAYOUT NAME - 06.pn	DATE: 1/13/2023 9:57 AM	BY: CORDINA WOYCHIK	SCALE: 1 IN=100 FT	WIS007CADD05 SHEET 44
HWY: STH 131				



Proposal Schedule of Items

Proposal ID: 20230214007 Project(s): 5130-05-63

Federal ID(s): WISC 2023238

SECTION: 0001 Contract Items

Alt Set ID: Alt Mbr ID:

Proposal Line Number	Item ID Description	Approximate Quantity and Units	Unit Price	Bid Amount
0090	511.1200 Temporary Shoring (structure) 02. C-41-37	284.000 SF	_____.	_____.
0092	511.1200 Temporary Shoring (structure) 03. C-41-38	412.000 SF	_____.	_____.
0094	516.0500 Rubberized Membrane Waterproofing	43.000 SY	_____.	_____.
0096	521.3136 Culvert Pipe Corrugated Steel 36-Inch	8.000 LF	_____.	_____.
0098	612.0406 Pipe Underdrain Wrapped 6-Inch	193.000 LF	_____.	_____.
0100	614.0400 Adjusting Steel Plate Beam Guard	2,725.000 LF	_____.	_____.
0102	614.0950 Replacing Guardrail Posts and Blocks	46.000 EACH	_____.	_____.
0104	618.0100 Maintenance And Repair of Haul Roads (project) 01. 5130-05-63	1.000 EACH	_____.	_____.
0106	619.1000 Mobilization	1.000 EACH	_____.	_____.
0108	624.0100 Water	14.000 MGAL	_____.	_____.
0110	625.0500 Salvaged Topsoil	500.000 SY	_____.	_____.
0112	628.1504 Silt Fence	600.000 LF	_____.	_____.
0114	628.1520 Silt Fence Maintenance	600.000 LF	_____.	_____.
0116	628.1905 Mobilizations Erosion Control	5.000 EACH	_____.	_____.
0118	628.1910 Mobilizations Emergency Erosion Control	3.000 EACH	_____.	_____.
0120	628.2008 Erosion Mat Urban Class I Type B	500.000 SY	_____.	_____.



Proposal Schedule of Items

Proposal ID: 20230214007 Project(s): 5130-05-63

Federal ID(s): WISC 2023238

SECTION: 0001 Contract Items

Alt Set ID: Alt Mbr ID:

Proposal Line Number	Item ID Description	Approximate Quantity and Units	Unit Price	Bid Amount
0208	SPV.0180 Special 01. Removing Distressed Pavement Milling	615.000 SY	_____.	_____.
0210	SPV.0060 Special 05. Replacing Guardrail Posts and Blocks - EAT	48.000 EACH	_____.	_____.
Section: 0001			Total:	_____.
			Total Bid:	_____.

