



Wisconsin Department of Transportation

January 6, 2026

Division of Transportation Systems
Development
Bureau of Project Development
4822 Madison Yards Way, 4th Floor South
Madison, WI 53705

Telephone: (608) 266-1631
Facsimile (FAX): (608) 266-8459

NOTICE TO ALL CONTRACTORS:

Proposal #47: 7878-03-70
WCL - Menomonie
Irving Creek Bridge B-17-0238
CTH P
Dunn County

Letting of January 13, 2026

This is Addendum No. 01, which provides for the following:

Special Provisions:

Revised Special Provisions	
Article No.	Description
6	Utilities

Plan Sheets:

Revised Plan Sheets	
Plan Sheet	Plan Sheet Title (brief description of changes to sheet)
11	Plan and Profile: utility locations from Station 9+40 to Station 13+00 revised
40	Cross Sections 01: utility locations from Station 9+40 to Station 13+00 revised
41	Cross Sections 02: utility locations from Station 9+40 to Station 13+00 revised
42	Cross Sections 03: utility locations from Station 9+40 to Station 13+00 revised

The responsibility for notifying potential subcontractors and suppliers of these changes remains with the prime contractor.

Sincerely,

Mike Coleman

Proposal Development Specialist
Proposal Management Section

ADDENDUM NO. 01

7878-03-70

January 6, 2026

Special Provisions

6. Utilities.

Replace entire section titled Dunn Energy Cooperative (Electric) with the following:

Dunn Energy Cooperative (Electric) has existing overhead facilities from Station 6+00 to Station 9+40, LT and Station 9+40 to Station 11+00, RT. Dunn Energy has underground facilities along the right side of CTH P from Station 10+85 to Station 13+50, LT.


Should the contractor request Dunn Energy power poles be temporarily moved, contact Dunn Energy 7 days prior to coordinate temporary relocation. This work is estimated to take 1 day to complete.


Plan Sheets

The following 8½ x 11-inch sheets are attached and made part of the plans for this proposal:
Revised: 11, 40, 41, and 42.


END OF ADDENDUM

Addendum No. 01
ID 7878-03-70
Revised Sheet 11
January 6, 2026

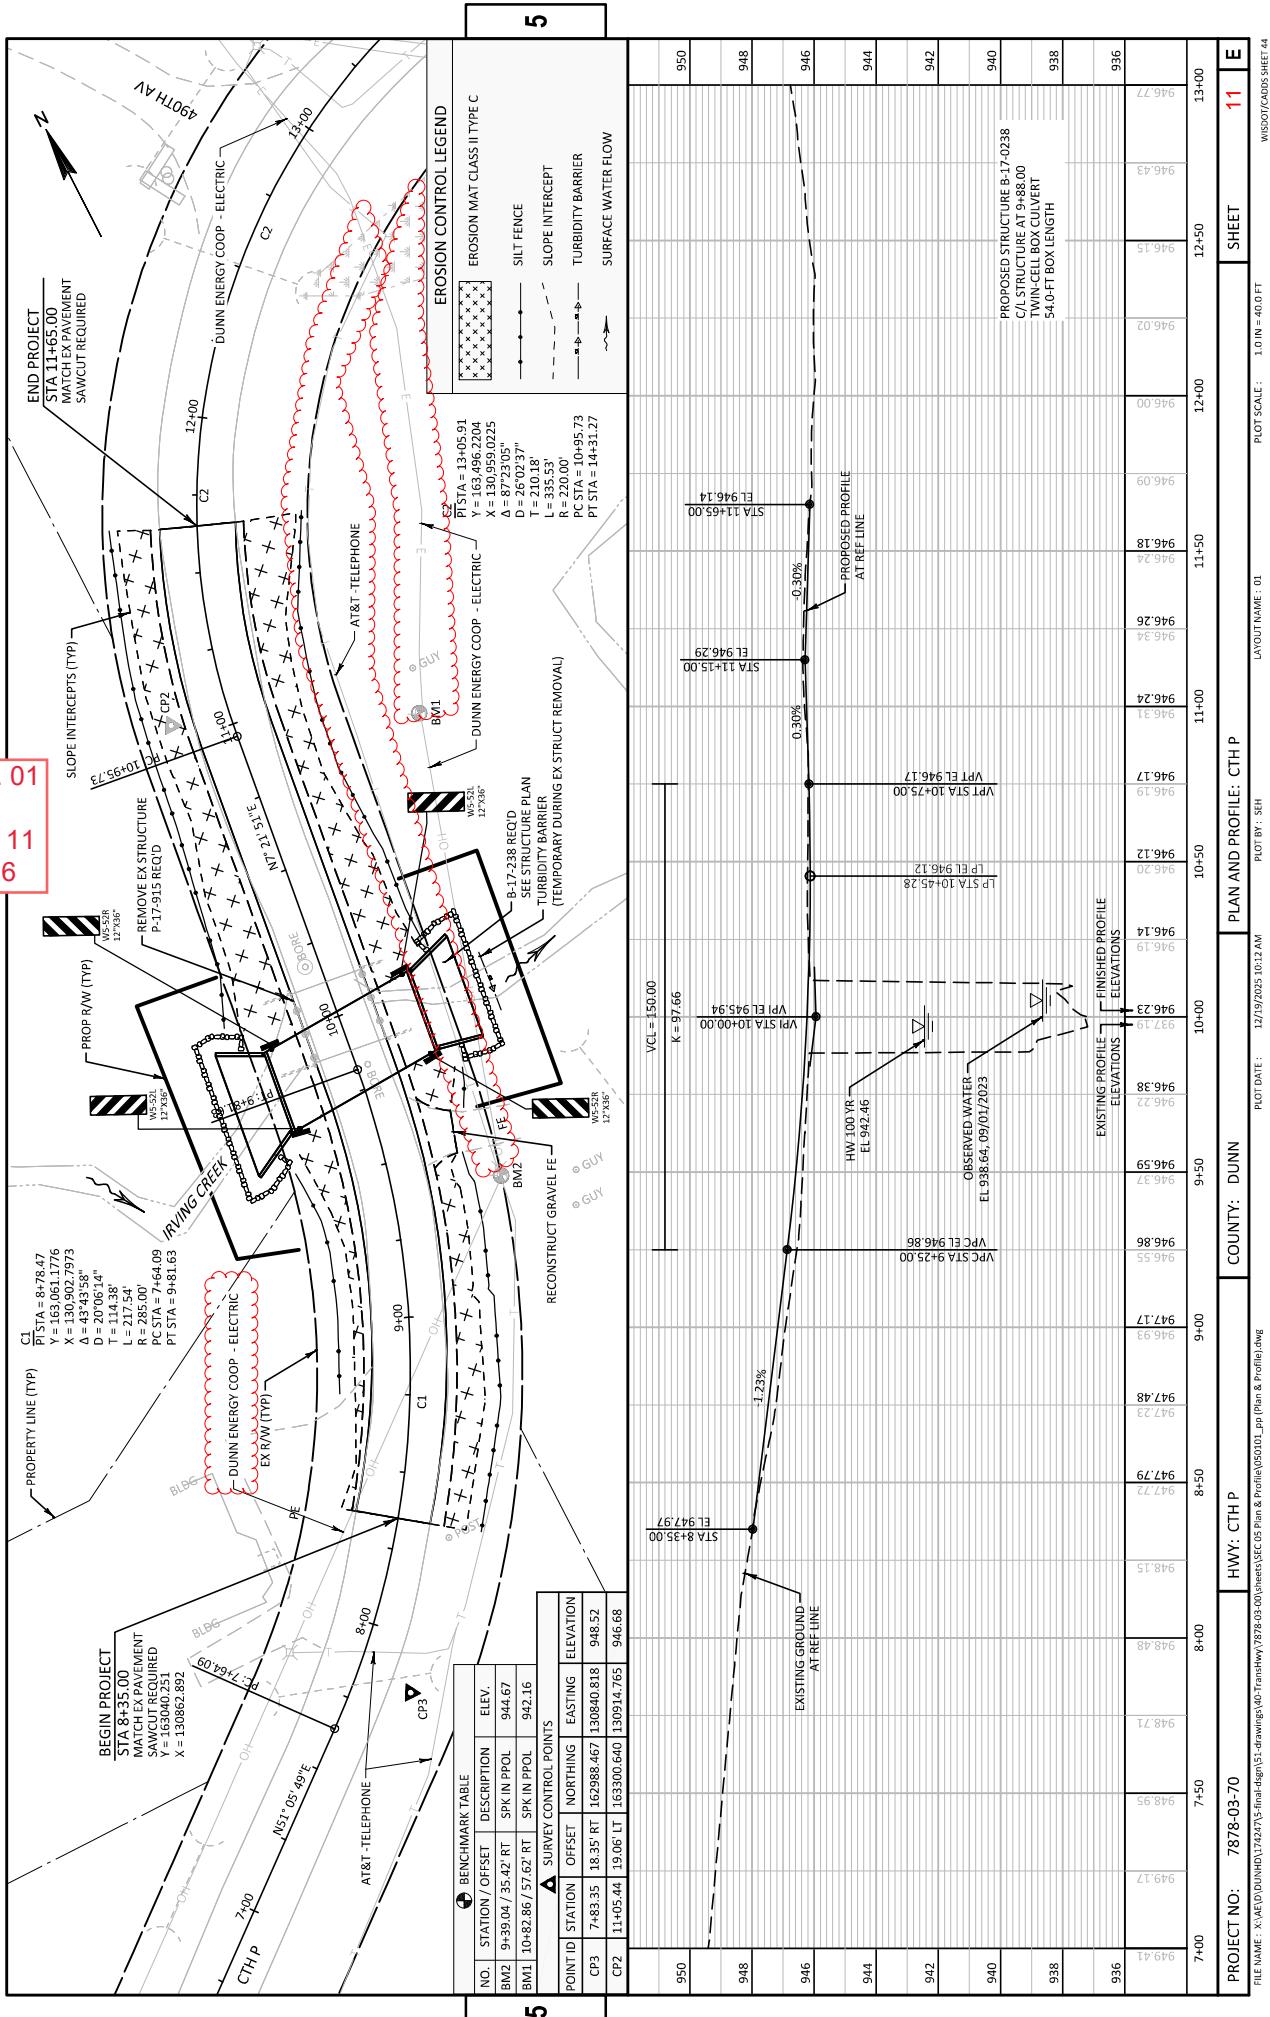

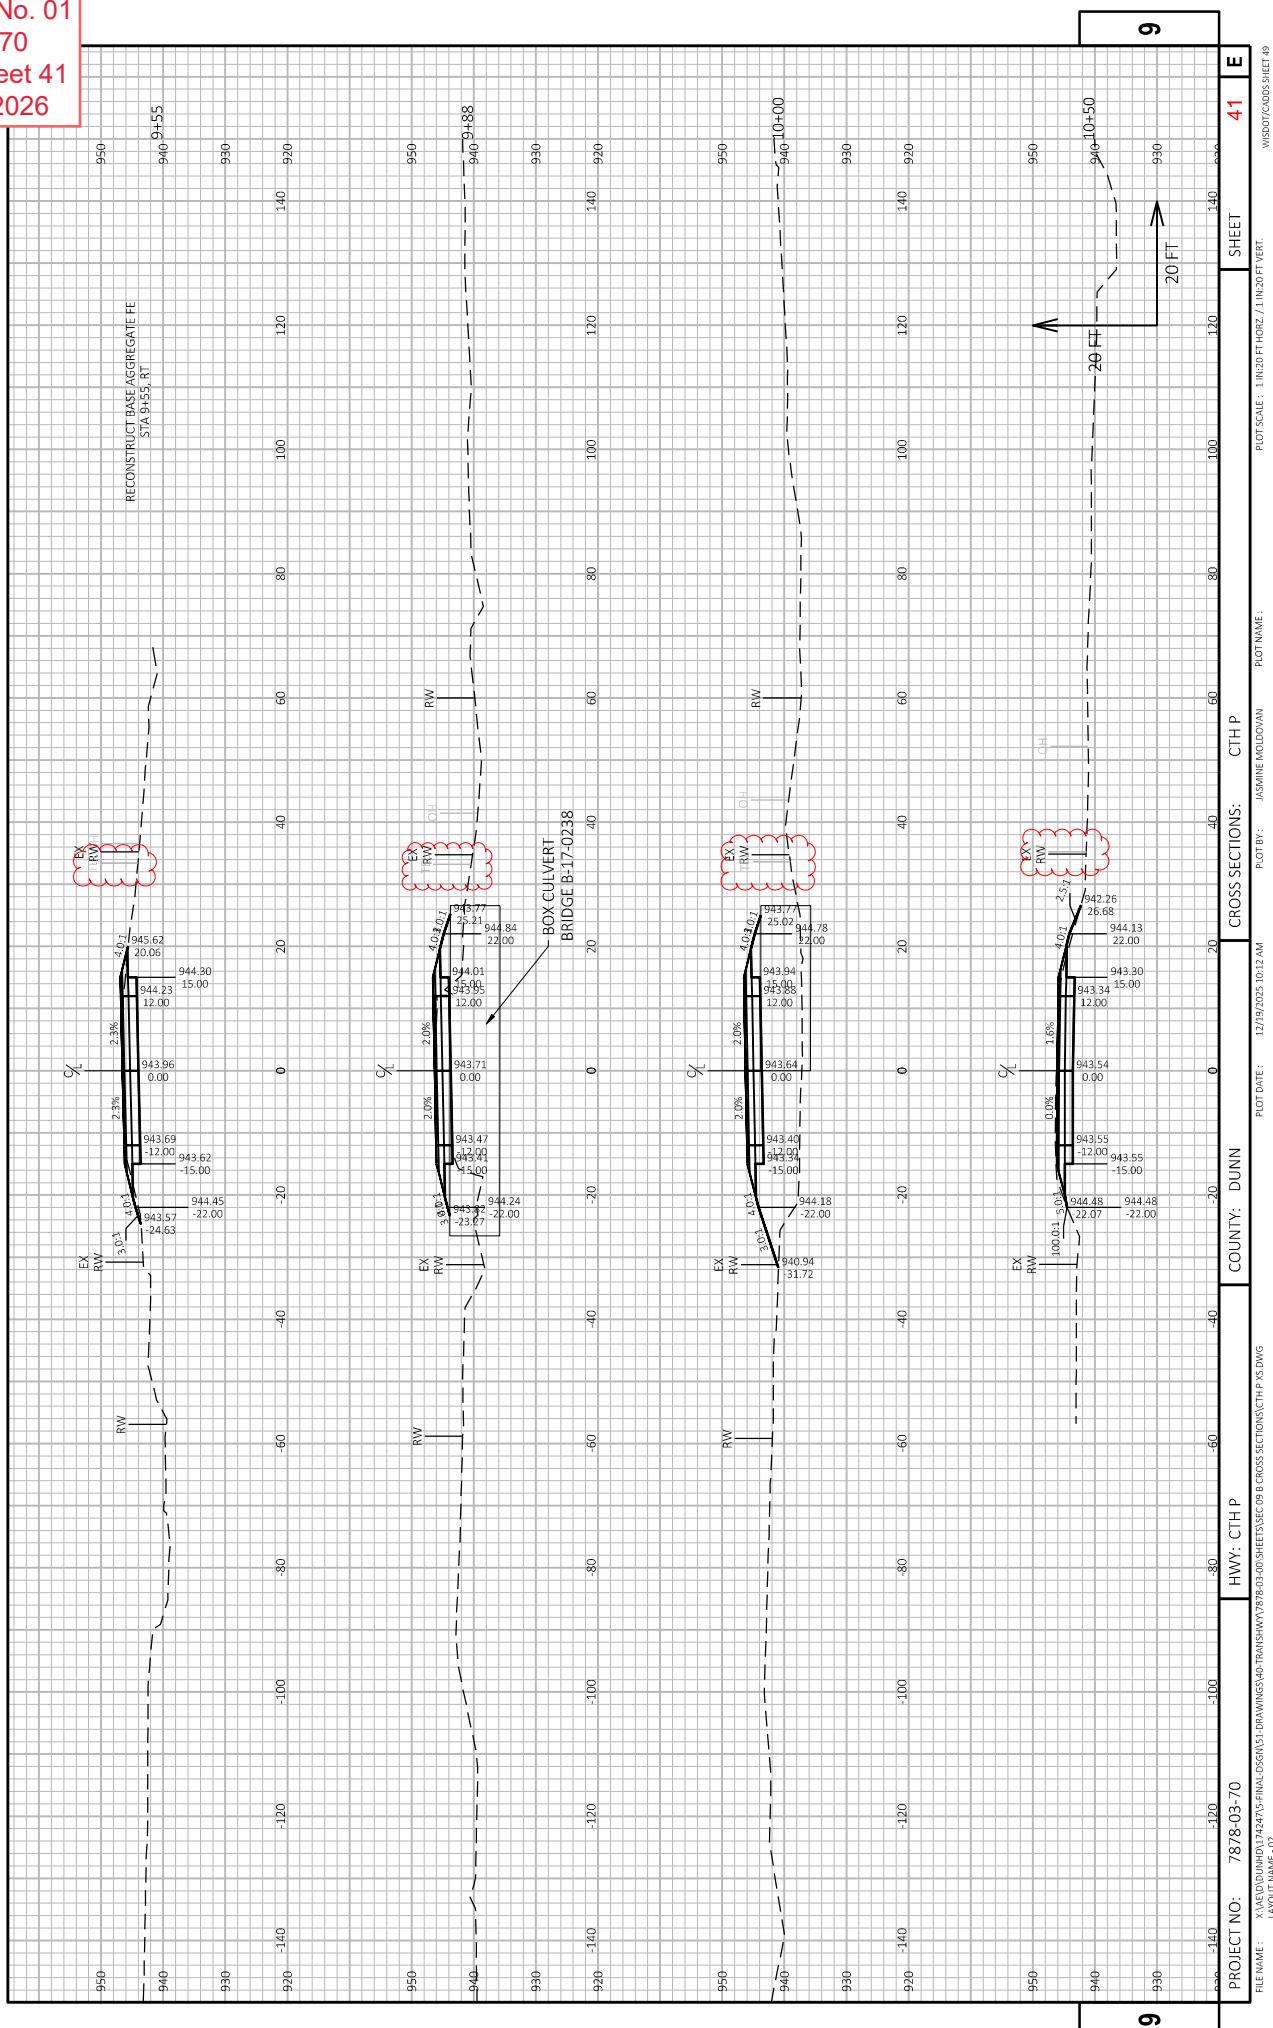

୭

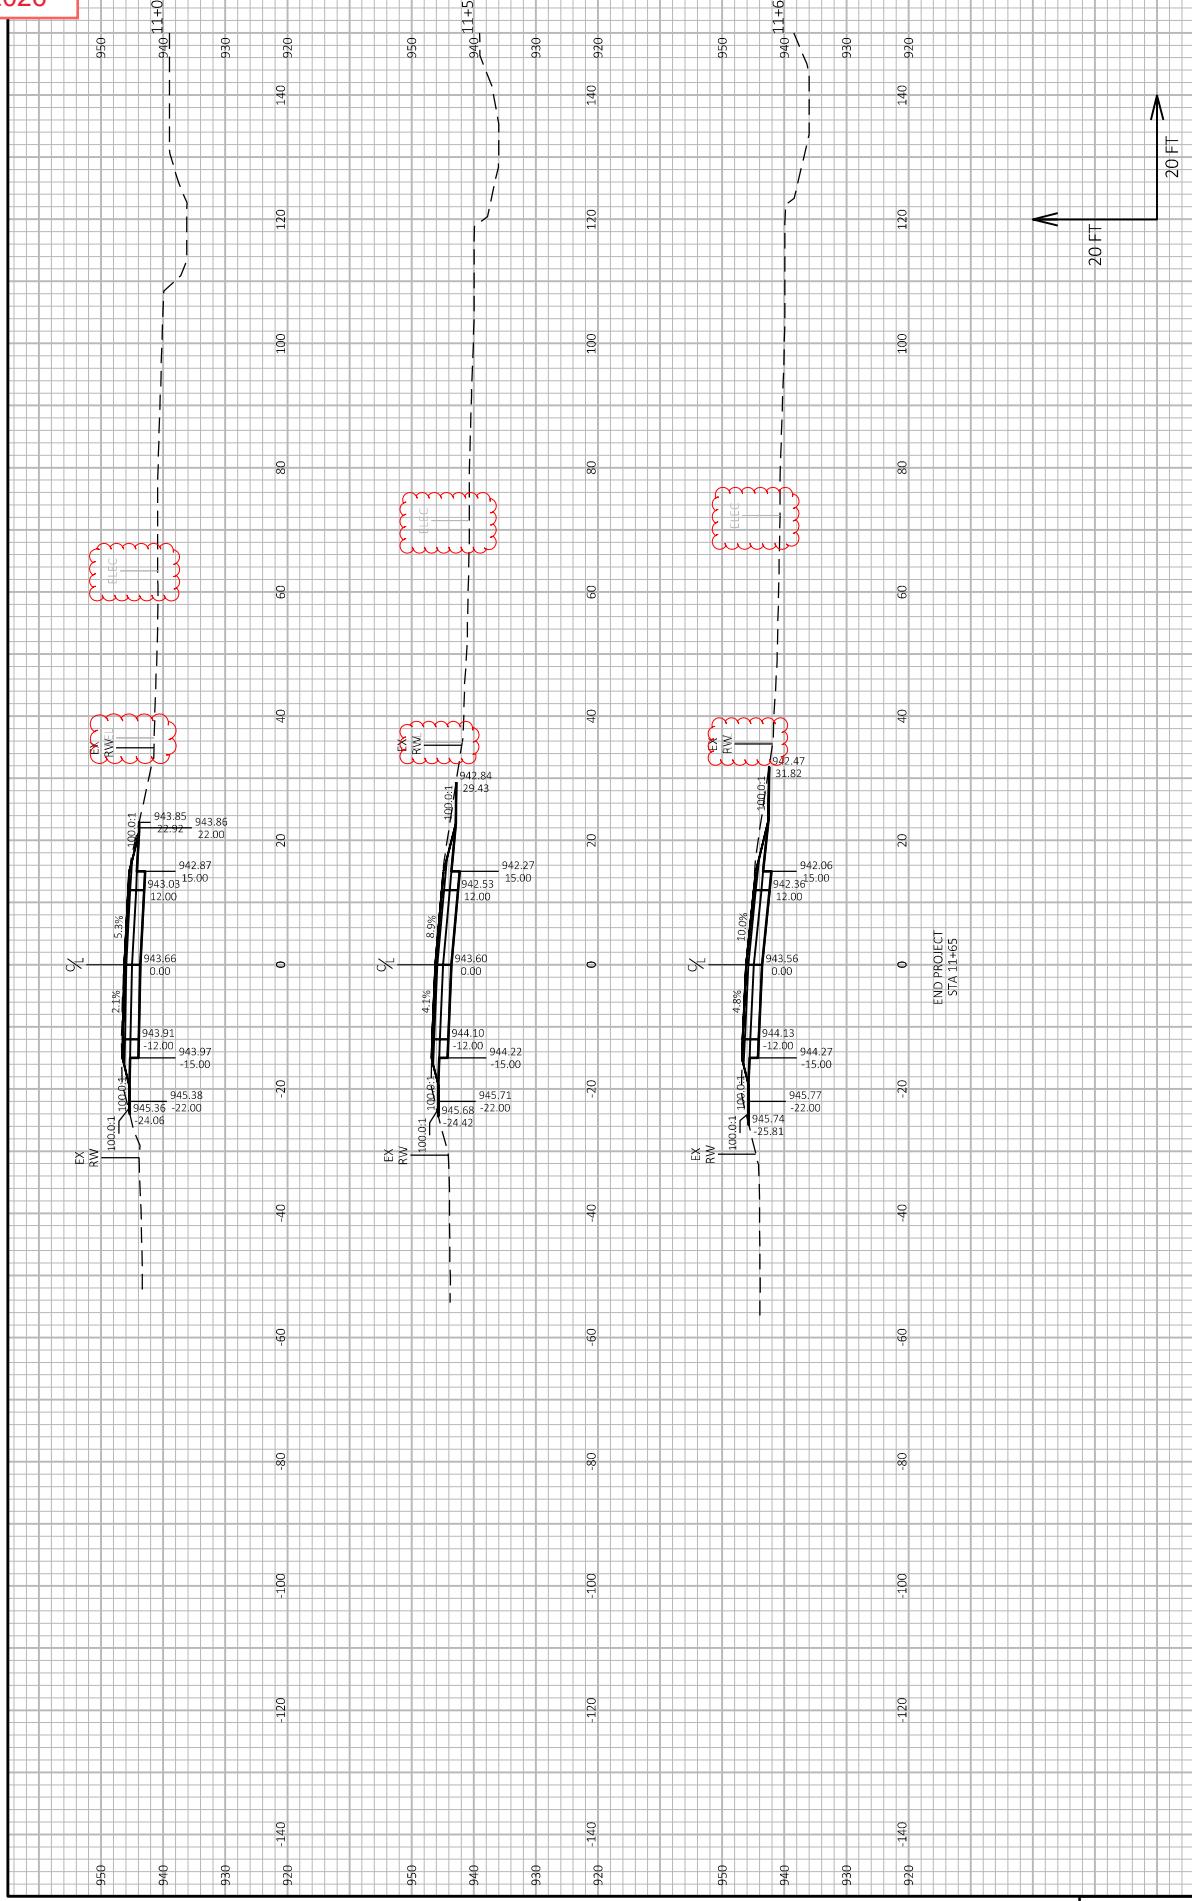

PROJECT NO: 7878-03-70
FILE NAME: X:\EAD\DUINHD\1742475-FINAL.DWG
LAYOUT NAME: -03

PROOF OF CONCEPT

WISDOT/CADDS SHEET 45