



Wisconsin Department of Transportation

July 2, 2025

Division of Transportation Systems Development

Bureau of Project Development
4822 Madison Yards Way, 4th Floor South
Madison, WI 53705

Telephone: (608) 266-1631
Facsimile (FAX): (608) 266-8459

NOTICE TO ALL CONTRACTORS:

Proposal #02: 1030-43-71, WISC 2025547
IH Mitchell I/C
WB I43/I94 35th St-Rawson Ave-
Howard Ave
IH 41
Milwaukee County

1030-43-72, WISC 2025496
IH Mitchell I/C
EB I43/I94 35th St-Rawson Ave-
Howard Ave
IH 41
Milwaukee County

Letting of July 8, 2025

This is Addendum No. 01, which provides for the following:

Special Provisions:

Revised Special Provisions	
Article No.	Description
3	Prosecution and Progress
7	Holiday and Special Event Work Restrictions.
70	Foam-Jacking, Item SPV.0085.01
74	Marking Line Wet Reflective Epoxy 6-Inch, Item SPV.0090.04. Marking Line Wet Reflective Epoxy 10-Inch, Item SPV.0090.05.
85	Expansion Joint Repair Rapid Set, Item SPV.0180.02; Concrete Pavement Approach Slab Repair Rapid Set, Item SPV.0180.03; Concrete Pavement Repair Rapid Set, Item SPV.0180.07.

Schedule of Items:

Revised Bid Item Quantities					
Bid Item	Item Description	Unit	Proposal Total Prior to Addendum	Proposal Quantity Change (-)	Proposal Total After Addendum
646.2020	Marking Line Epoxy 6-Inch	LF	66,319	2,597	68,916
646.4020	Marking Line Epoxy 10-Inch	LF	3,528	3,516	7,044
SPV.0090.05	Marking Line Wet Reflective Epoxy 10-Inch	LF	8,061	-3,516	4,545

Added Bid Item Quantities					
Bid Item	Item Description	Unit	Proposal Total Prior to Addendum	Quantity Added	Proposal Total After Addendum
646.9200	Marking Removal Line Wide	LF	0	340	340

Deleted Bid Item Quantities					
Bid Item	Item Description	Unit	Proposal Total Prior to Addendum	Proposal Quantity Change (-)	Proposal Total After Addendum
SPV.0090.04	Marking Line Wet Reflective Epoxy 6-Inch	LF	2,597	-2,597	0

Plan Sheets:

Revised Plan Sheets 1030-43-71	
Plan Sheet	Plan Sheet Title (brief description of changes to sheet)
123-143	Pavement Marking Legend and bid items revised for bridges and ramps
326-327	Miscellaneous Quantities (switched bid items for pavement marking on bridges and ramps)

Revised Plan Sheets 1030-43-72	
Plan Sheet	Plan Sheet Title (brief description of changes to sheet)
148-169	Pavement Marking Legend and bid items revised for bridges and ramps
354-357	Miscellaneous Quantities (switched bid items for pavement marking on bridges and ramps)

The responsibility for notifying potential subcontractors and suppliers of these changes remains with the prime contractor.

Sincerely,

Mike Coleman

Proposal Development Specialist
Proposal Management Section

ADDENDUM NO. 01

1030-43-71

July 1, 2025

Special Provisions

3. Prosecution and Progress

*Replace entire section titled **Fall and Winter Work Restrictions** with the following:*

Fall and Winter Work Restrictions

The schedule has base patching and approach slab repair work in 2025. Schedule work such that all base patching and approach slab repairs are completed in 2025 before the winter shut down. No work requiring lane closures shall take place from November 16, 2025 until March 15, 2026, both dates inclusive. Restore the traffic configuration prior to November 16, 2025 to the existing (pre-construction) traffic configuration. Restore all existing pavement and pavement markings prior to the winter shutdown. All traffic control, equipment and materials removed from the project site during the winter shut down. No lane closures will be allowed during the winter shut down unless approved by the engineer.

To revise the start date of the winter shutdown for Project ID 1030-43-71 and/or 1030-43-72, submit a written request to the engineer at least two weeks before November 15, 2025. The engineer will approve or deny that request based on the conditions cited in the request. Additional Holiday restrictions for Christmas and New Years will apply.

7. Holiday and Special Event Work Restrictions.

*Add the following after the last paragraph under section titled **Freeway Special Event Restrictions**:*

During Summerfest, June 18-20, June 25-27, and July 2-4, 2026, maintain at least one open lane on IH 41/43/94/894, and the system ramps until one hour after the event closes each night.

During the Wisconsin State Fair, August 6-16, 2026, maintain at least one open lane on IH 41/43/94/894, and the system ramps, until one hour after the event closes each night.

Any exceptions to this work restriction must be approved by the engineer in writing. Roadway and traffic control maintenance required by the contractor shall be performed as needed during this work restriction.

Coordinate with the engineer for approval in advance of performing necessary roadway or traffic control maintenance work.

Special event work restrictions do not apply to roadways or ramps already closed long-term during construction as shown on the plans. New long-term closures of ramps and roadways must be coordinated with the special event work restrictions.

70. Foam-Jacking, Item SPV.0085.01

*Replace paragraph four under section titled **B Materials** with the following::*

Provide a general certification from the HDP manufacturer for each shipment stating the material meets or exceeds the following requirements and must be submitted to the engineer two weeks prior to the start of the foam jacking work.

**74. Marking Line Wet Reflective Epoxy 6-Inch, Item SPV.0090.04.
Marking Line Wet Reflective Epoxy 10-Inch, Item SPV.0090.05.**

Replace entire article with the following:

74. Marking Line Wet Reflective Epoxy 10-Inch, Item SPV.0090.05.

A Description

This special provision describes applying wet reflective epoxy marking conforming to standard spec 646, as the plans show, and as follows.

B Materials

Furnish wet reflective epoxy pavement marking materials conforming of standard spec 646.2.

C Construction

Apply wet reflective epoxy pavement marking conforming to standard spec 646.3, except that grooving is not necessary. Use existing groove if present.

D Measurement

The department will measure Marking Line Wet Reflective Epoxy by the linear foot, acceptably completed, measured once as the length of the centerline of the completed installation.

E Payment

The department will pay for measured quantities at the contract unit price under the following bid item:

ITEM NUMBER	DESCRIPTION	UNIT
SPV.0090.05	Marking Line Wet Reflective Epoxy 10-Inch	LF

Payment is full compensation for cleaning and preparing the pavement surface, furnishing and installing the material; and for furnishing all labor, tools, equipment, and incidentals necessary to complete the work.

**85. Expansion Joint Repair Rapid Set, Item SPV.0180.02;
Concrete Pavement Approach Slab Repair Rapid Set, Item SPV.0180.03;
Concrete Pavement Repair Rapid Set, Item SPV.0180.07.**

Replace paragraph one under section titled B Materials with the following:

Furnish a rapid setting non-shrink material designed for repairing concrete bridge decks from the department's Approved Products List for "Horizontal Rapid Set Concrete Patch Material". The material shall be capable of obtaining a minimum compressive strength of 2,000 psi within 3 hours. The patch material must be compatible with the existing concrete pavement, reinforcing steel, and the polymer or asphalt overlay product (if applicable); and have a proven record of at least five successful applications in climates similar to Wisconsin. The use of chloride accelerators or other corrosion inducing products is prohibited.

Replace paragraph six under section titled C Construction with the following:

Place the patch material on existing asphaltic base or existing base course shaped to the required cross section. Remove concrete rubble and foreign material with minimal disturbance of the base. Fill low areas or depressions in the base following removal operations with either compacted aggregate base or additional concrete. Apply a bonding agent, as necessary and as recommend by the patch material manufacturer, to surfaces to be covered by patch material.

*Replace the last paragraph under section titled **C Construction** with the following:*

Submit certified test results from an independent lab showing that the patch material obtained 2,000 psi within 3 hours of placement.

Schedule of Items


Attached, dated July 2, 2025, are the revised Schedule of Items Pages 1 – 15.

Plan Sheets


The following 8½ x 11-inch sheets are attached and made part of the plans for this proposal:

Revised: 123-143, 326-327 (1030-43-71); 148-169, 354-357 (1030-43-72)

END OF ADDENDUM

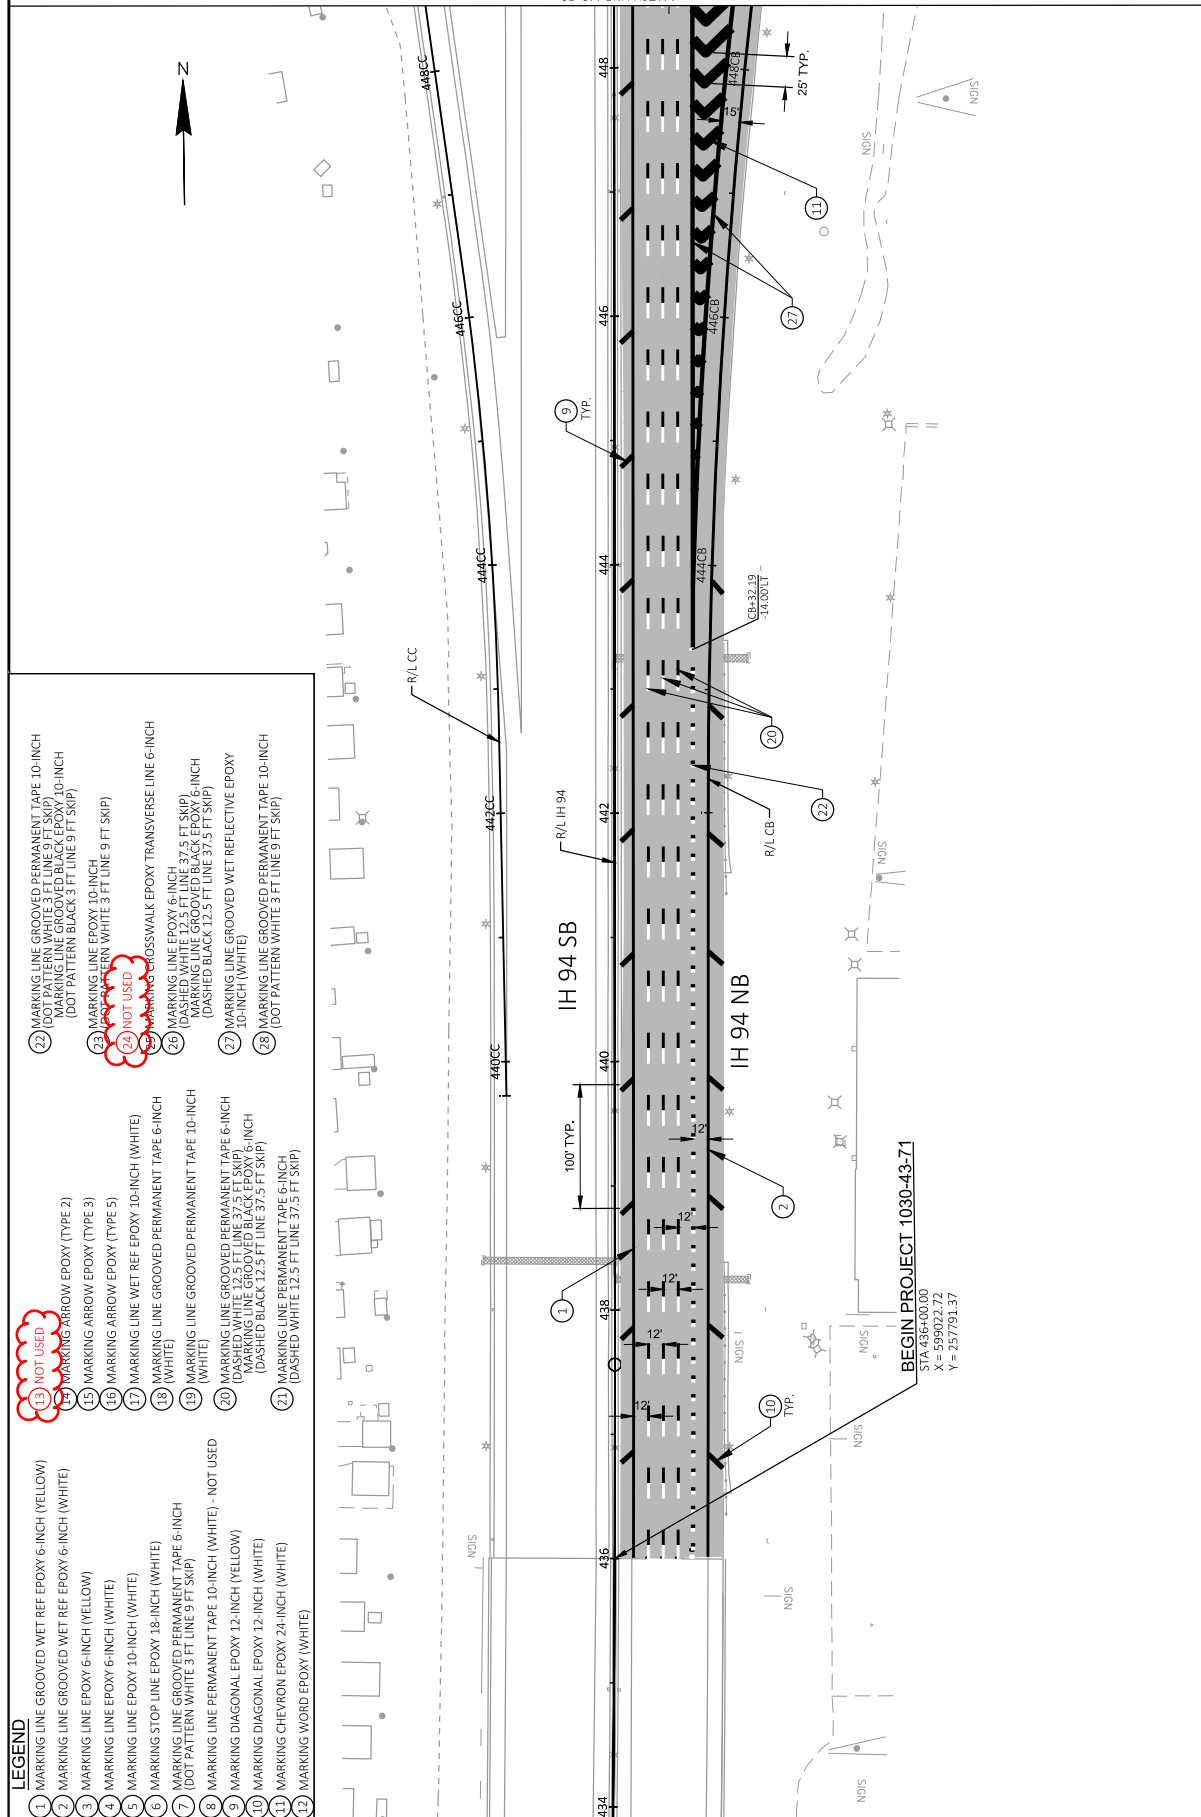


Addendum No. 01
ID 1030-43-71
Revised Sheet 124
July 2, 2025

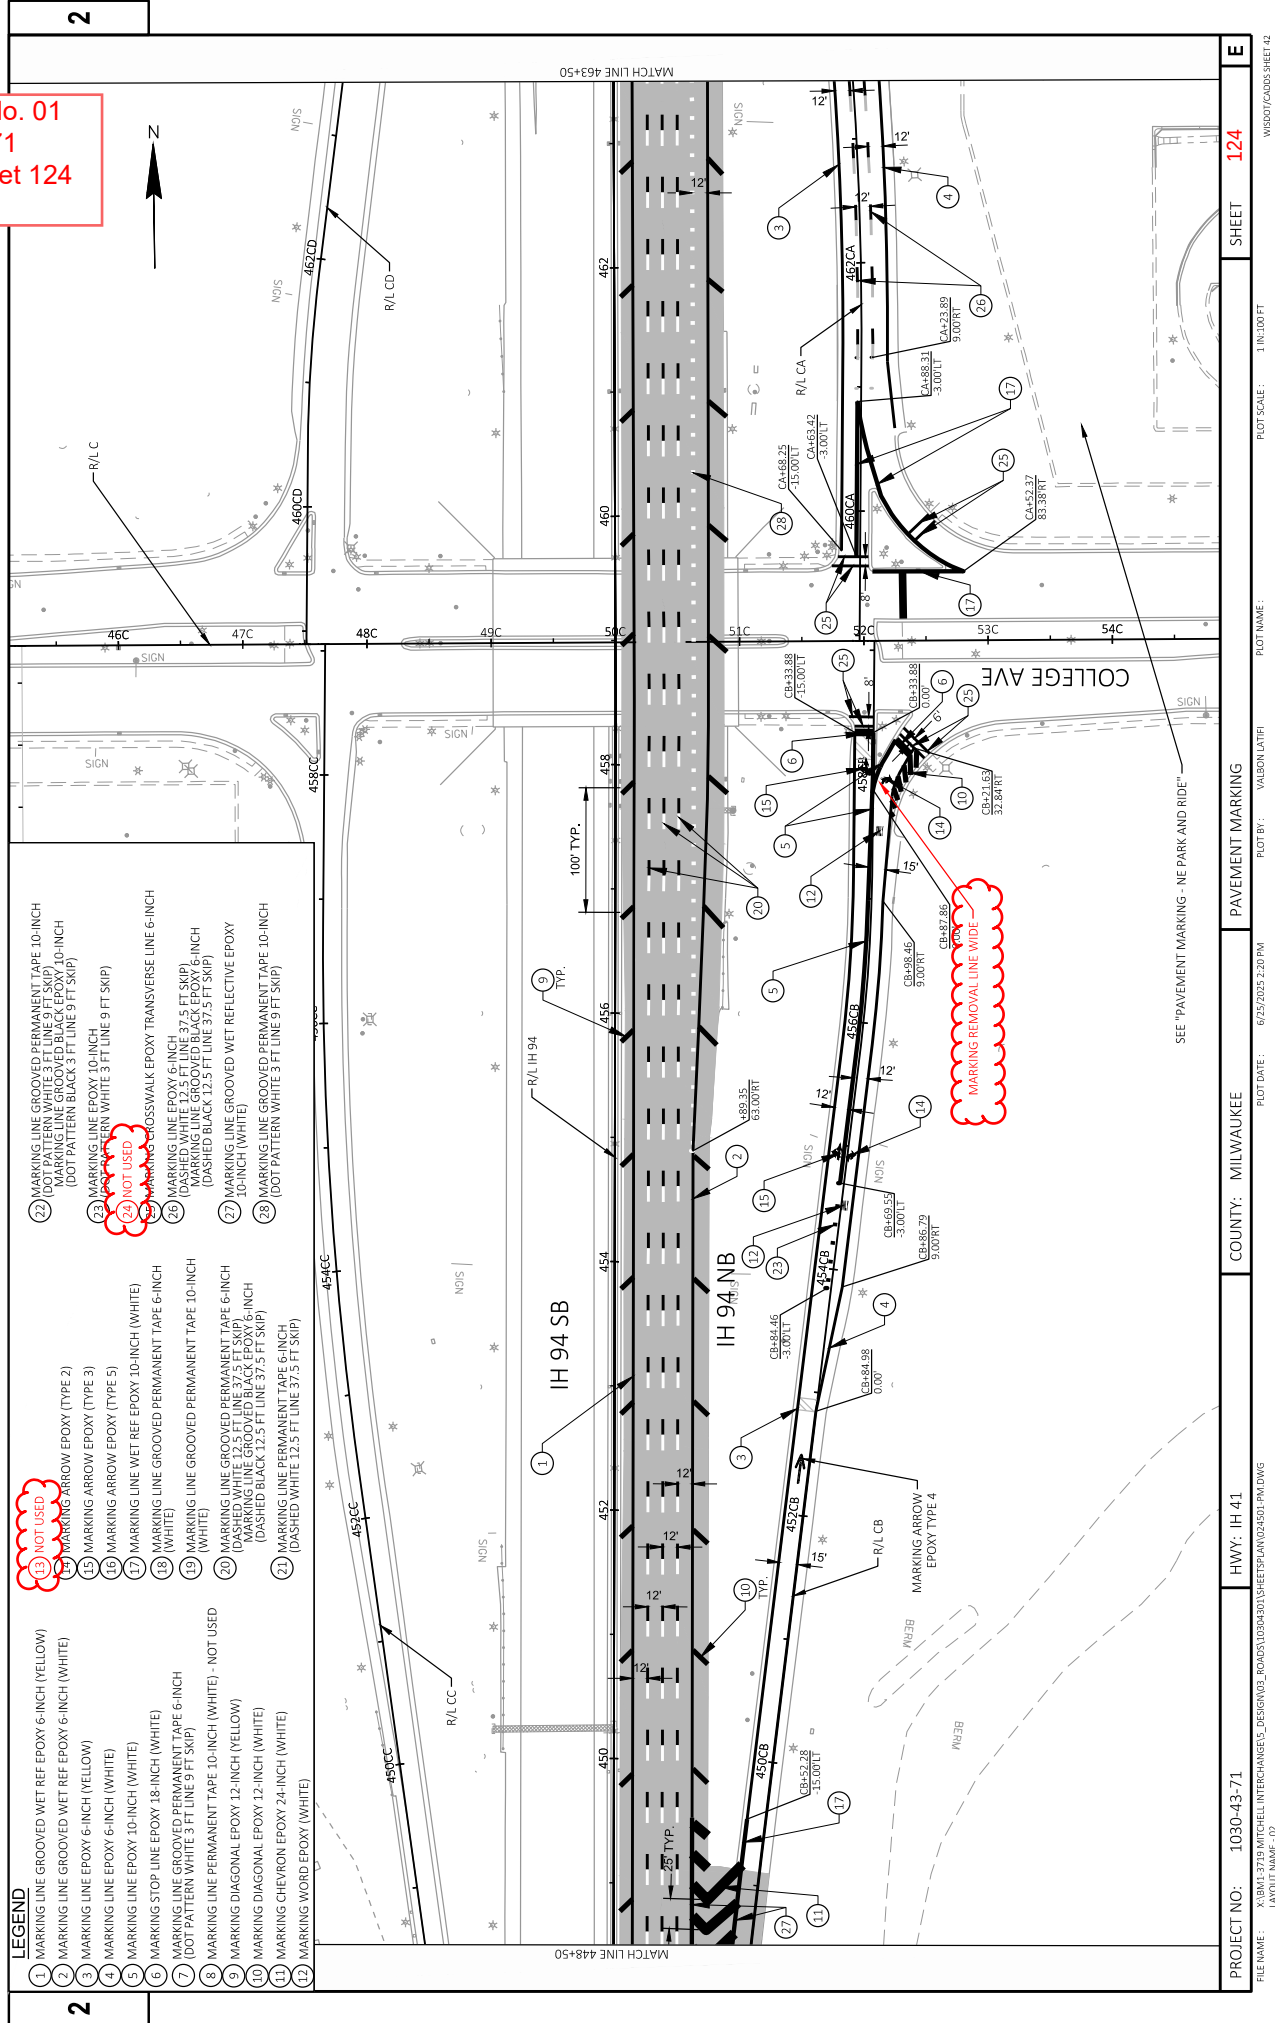

13 NOT USED


1. MARKING LINE GROOVED WET REF EPOXY 6-INCH (YELLOW)
2. MARKING LINE GROOVED WET REF EPOXY 6-INCH (WHITE)
3. MARKING LINE EPOXY 6-INCH (YELLOW)
4. MARKING LINE EPOXY 6-INCH (WHITE)
5. MARKING LINE EPOXY 10-INCH (WHITE)
6. MARKING STOP LINE EPOXY 18-INCH (WHITE)
7. MARKING LINE GROOVED PERMANENT TAPE 6-INCH (DOT PATTERN WHITE 3 FT LINE 9 FT SKIP)
8. MARKING LINE PERMANENT TAPE 10-INCH (WHITE) - NOT USED
9. MARKING DIAGONAL EPOXY 12-INCH (YELLOW)
10. MARKING DIAGONAL EPOXY 12-INCH (WHITE)
11. MARKING CHEVRON EPOXY 24-INCH (WHITE)
12. MARKING WORD EPOXY (WHITE)


- 22 MARKING LINE GROOVED PERMANENT TAPE 10-INCH
(DOT PATTERN WHITE 3 FT LINE 9 FT SKIP)
(DOT PATTERN BLACK 3 FT LINE 9 FT SKIP)
(DOT PATTERN WHITE 3 FT LINE 9 FT SKIP)
- 24 **NOT USED**
- 25 MARKING CROSSWALK EPOXY TRANSVERSE LINE 6-INCH
(DOT PATTERN WHITE 3 FT LINE 9 FT SKIP)
- 26 MARKING LINE EPOXY 6-INCH
(DASHED WHITE 12.5 FT LINE 37.5 FT SKIP)
(DASHED BLACK 12.5 FT LINE 37.5 FT SKIP)
- 27 MARKING LINE GROOVED WET REFLECTIVE EPOXY
10-INCH (WHITE)
(DOT PATTERN WHITE 3 FT LINE 9 FT SKIP)
- 28 MARKING LINE GROOVED PERMANENT TAPE 10-INCH
(DOT PATTERN WHITE 3 FT LINE 9 FT SKIP)

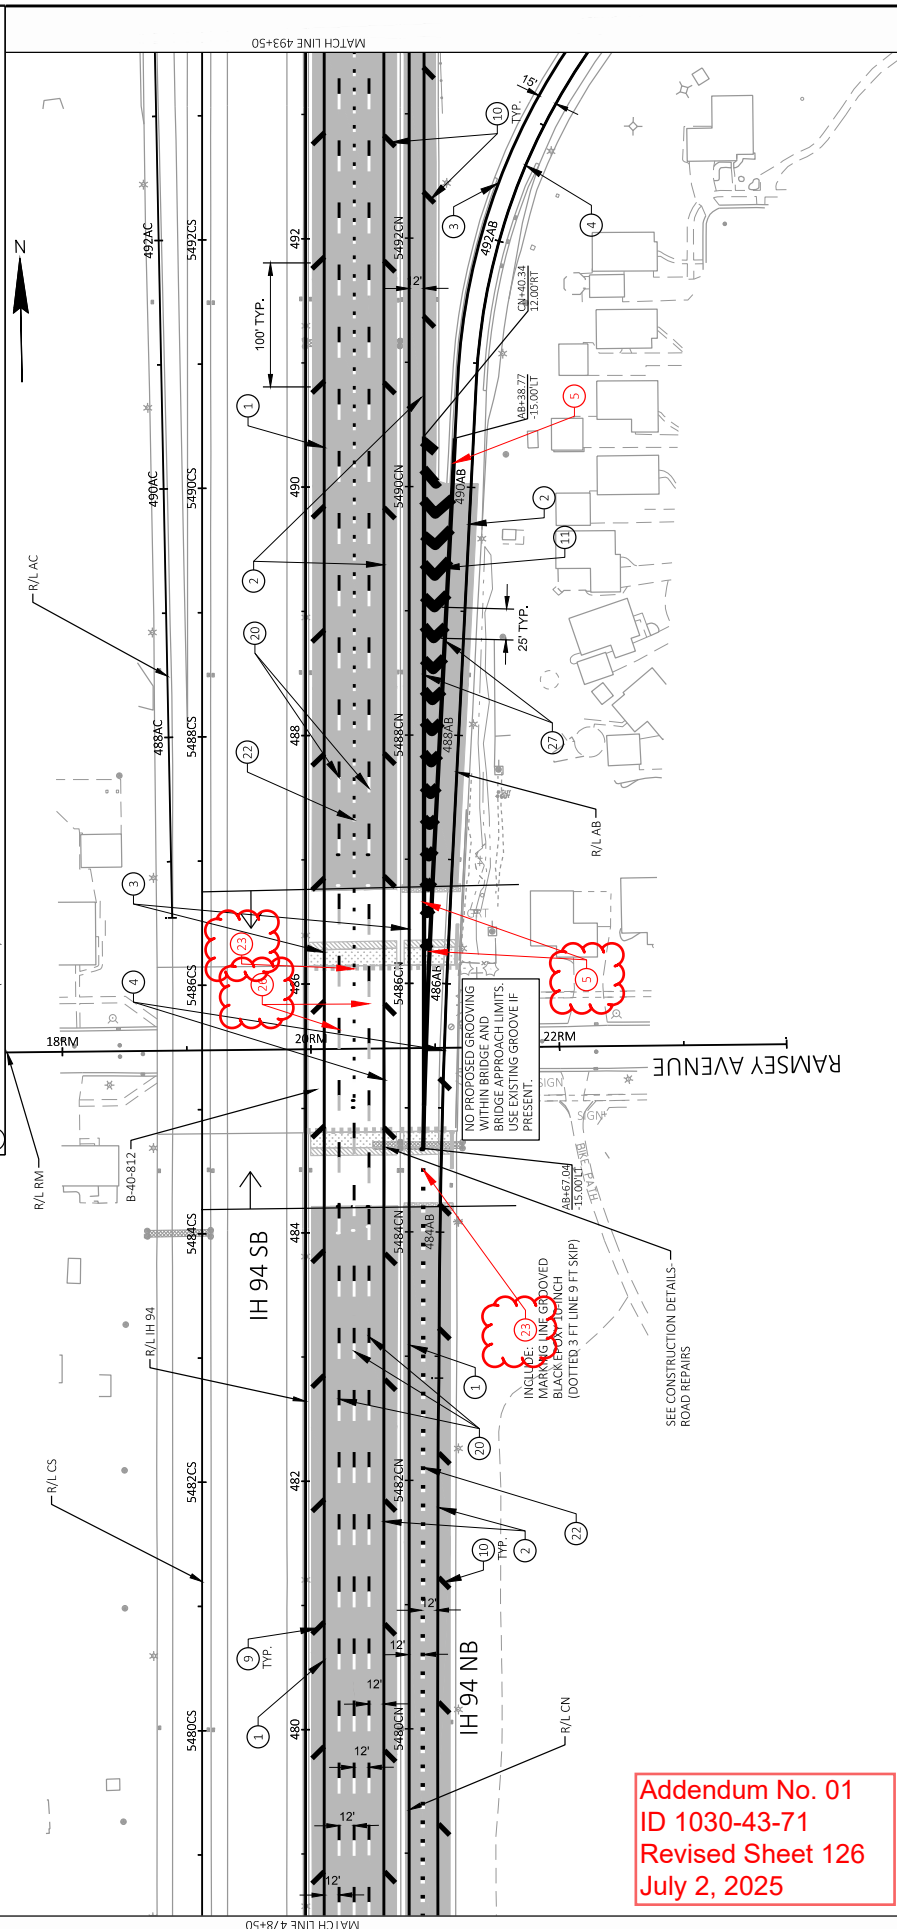


Addendum No. 01
ID 1030-43-71
Revised Sheet 126
July 2, 2025

- ## LEGEND

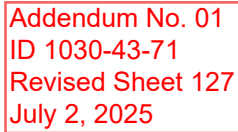

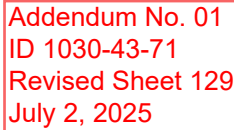


LEGEND	
1	MARKING LINE GROOVED WET REF EPOXY 6-INCH (YELLOW)
2	MARKING LINE GROOVED WET REF EPOXY 6-INCH (WHITE)
3	MARKING LINE GROOVED 6-INCH (YELLOW)
4	MARKING LINE GROOVED 6-INCH (WHITE)
5	MARKING LINE EPOXY 10-INCH (WHITE)
6	MARKING STOP LINE EPOXY 18-INCH (WHITE)
7	MARKING LINE GROOVED PERMANENT TAPE 6-INCH (DOT PATTERN WHITE 3 FT LINE 9 FT SKIP)
8	MARKING LINE PERMANENT TAPE 10-INCH (WHITE) - NOT USED
9	MARKING DIAGONAL EPOXY 12-INCH (YELLOW)
10	MARKING DIAGONAL EPOXY 12-INCH (WHITE)
11	MARKING CHEVRON EPOXY 24-INCH (WHITE)
12	MARKING WORD EPOXY (WHITE)
13	NOT USED
14	MARKING ARROW EPOXY (TYPE 2)
15	MARKING ARROW EPOXY (TYPE 3)
16	MARKING ARROW EPOXY (TYPE 5)
17	MARKING LINE WET REF EPOXY 10-INCH (WHITE)
18	MARKING LINE GROOVED PERMANENT TAPE 6-INCH (WHITE)
19	MARKING LINE GROOVED PERMANENT TAPE 10-INCH (WHITE)
20	MARKING LINE GROOVED PERMANENT TAPE 6-INCH (DASHED WHITE 12.5 FT LINE 37.5 FT SKIP) (DASHED BLACK 12.5 FT LINE 37.5 FT SKIP)
21	MARKING LINE PERMANENT TAPE 6-INCH (DASHED WHITE 12.5 FT LINE 37.5 FT SKIP)
22	MARKING LINE GROOVED PERMANENT TAPE 10-INCH (DOT PATTERN WHITE 3 FT LINE 9 FT SKIP)
23	MARKING LINE GROOVED BLACK EPOXY 10-INCH (DOT PATTERN BLACK 3 FT LINE 9 FT SKIP)
24	MARKING LINE EPOXY 10-INCH (DOT PATTERN WHITE 3 FT LINE 9 FT SKIP)
25	NOT USED
26	MARKING LINE EPOXY 6-INCH (DASHED WHITE 12.5 FT LINE 37.5 FT SKIP) (MARKING LINE GROOVED BLACK EPOXY 6-INCH (DASHED BLACK 12.5 FT LINE 37.5 FT SKIP)
27	MARKING LINE GROOVED WET REFLECTIVE EPOXY 10-INCH (WHITE)
28	MARKING LINE GROOVED PERMANENT TAPE 10-INCH (DOT PATTERN WHITE 3 FT LINE 9 FT SKIP)

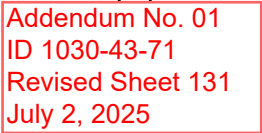


Addendum No. 01
ID 1030-43-71
July 2, 2025

LEGEND

- 1 MARKING LINE GROOVED WET REF EPOXY 6-INCH (YELLOW)
- 2 MARKING LINE GROOVED WET REF EPOXY 6-INCH (WHITE)
- 3 MARKING LINE EPOXY 6-INCH (YELLOW)
- 4 MARKING LINE EPOXY 6-INCH (WHITE)
- 5 MARKING LINE EPOXY 10-INCH (WHITE)
- 6 MARKING STOP LINE EPOXY 18-INCH (WHITE)
- 7 MARKING LINE GROOVED PERMANENT TAPE 6-INCH (DOT PATTERN WHITE 3 FT LINE 9 FT SKIP)
- 8 MARKING LINE PERMANENT TAPE 10-INCH (WHITE) - NOT USED
- 9 MARKING DIAGONAL EPOXY 12-INCH (YELLOW)
- 10 MARKING DIAGONAL EPOXY 12-INCH (WHITE)
- 11 MARKING CHEVRON EPOXY 24-INCH (WHITE)
- 12 MARKING WORD EPOXY (WHITE)
- 13 **NOT USED**
- 14 MARKING ARROW EPOXY (TYPE 2)
- 15 MARKING ARROW EPOXY (TYPE 3)
- 16 MARKING ARROW EPOXY (TYPE 5)
- 17 MARKING LINE WET REF EPOXY 10-INCH (WHITE)
- 18 MARKING LINE GROOVED PERMANENT TAPE 6-INCH (WHITE)
- 19 MARKING LINE GROOVED PERMANENT TAPE 10-INCH (WHITE)
- 20 MARKING LINE GROOVED PERMANENT TAPE 6-INCH (DASHED WHITE 12.5 FT LINE 37.5 FT SKIP)
- 21 MARKING LINE GROOVED PERMANENT TAPE 6-INCH (DASHED BLACK 12.5 FT LINE 37.5 FT SKIP)
- 22 MARKING LINE GROOVED PERMANENT TAPE 10-INCH (DOT PATTERN WHITE 3 FT LINE 9 FT SKIP)
- 23 MARKING LINE EPOXY 10-INCH
- 24 **NOT USED**
- 25 MARKING CROSSWALK EPOXY TRANSVERSE LINE 6-INCH (DASHED WHITE 12.5 FT LINE 37.5 FT SKIP)
- 26 MARKING LINE GROOVED BLACK EPOXY 6-INCH (DASHED BLACK 12.5 FT LINE 37.5 FT SKIP)
- 27 MARKING LINE GROOVED WET REFLECTIVE EPOXY 10-INCH (WHITE)
- 28 MARKING LINE GROOVED PERMANENT TAPE 10-INCH (DOT PATTERN WHITE 3 FT LINE 9 FT SKIP)

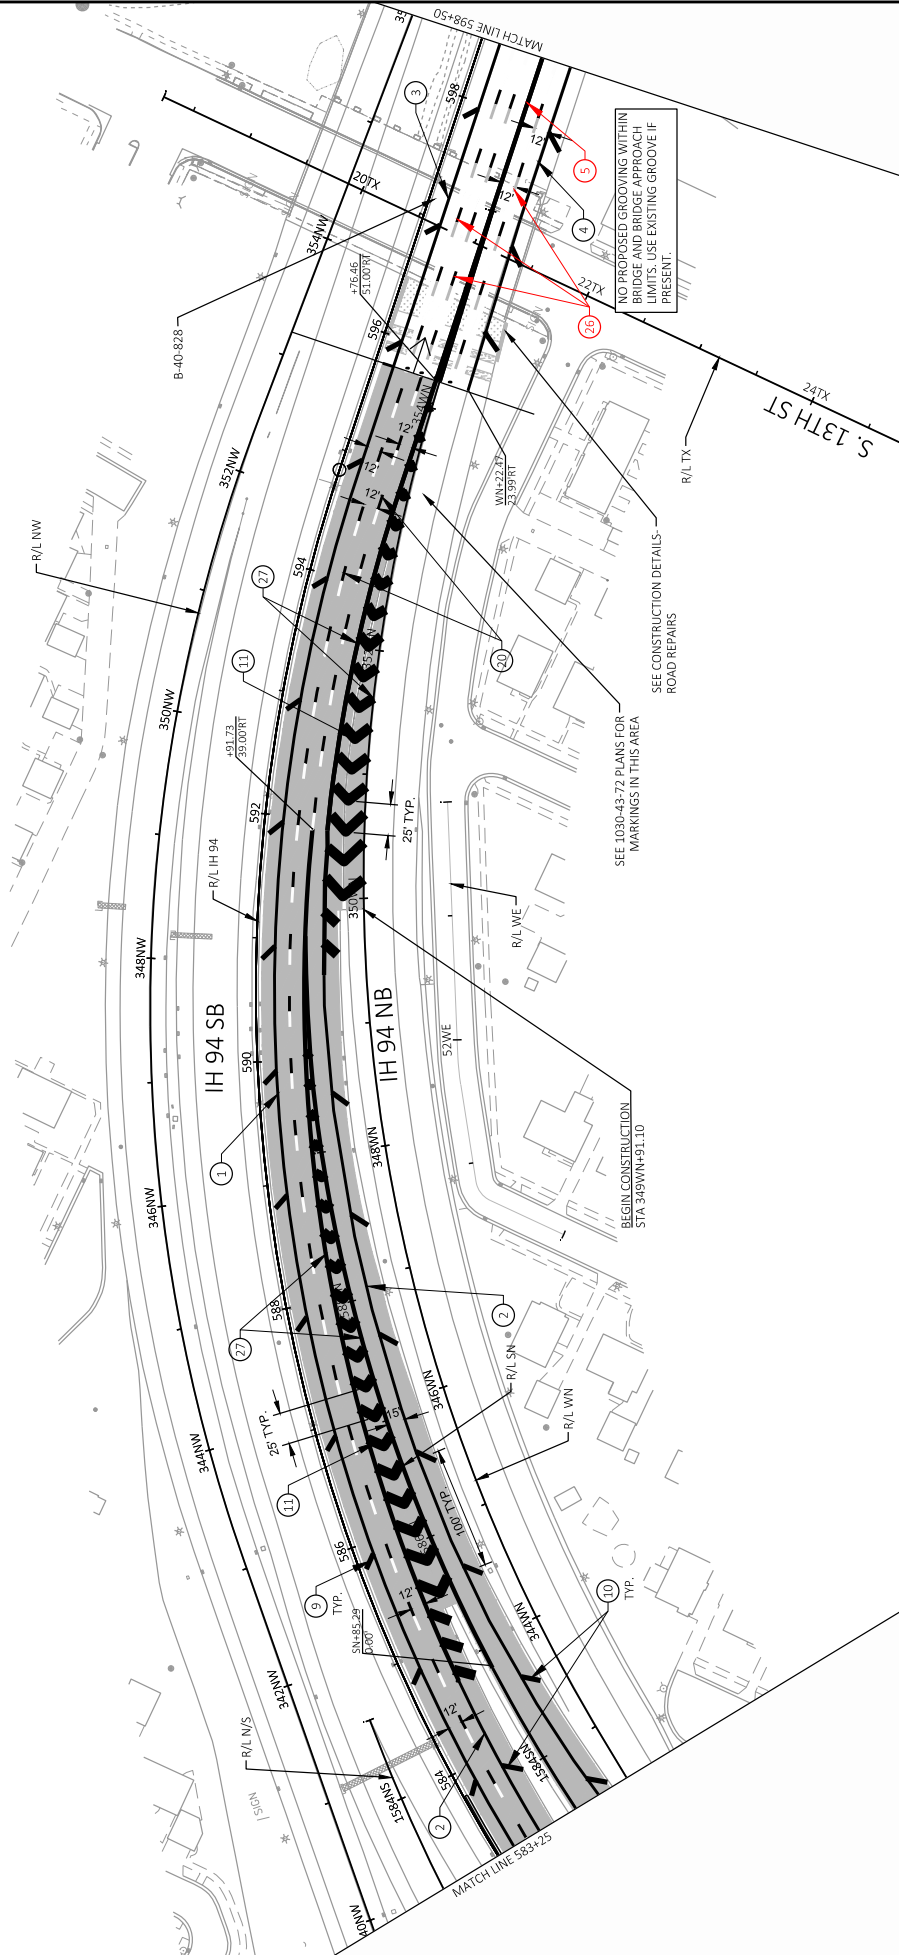


LEGEND	
1	MARKING LINE GROOVED WET REF EPOXY 6-INCH (YELLOW)
2	MARKING LINE GROOVED WET REF EPOXY 6-INCH (WHITE)
3	MARKING LINE GROOVED WET REF EPOXY 6-INCH (YELLOW)
4	MARKING LINE EPOXY 6-INCH (WHITE)
5	MARKING LINE EPOXY 10-INCH (WHITE)
6	MARKING STOP LINE EPOXY 18-INCH (WHITE)
7	MARKING LINE GROOVED PERMANENT TAPE 6-INCH (DOT PATTERN WHITE) 3 FT LINE 9 FT SKIP
8	MARKING LINE PERMANENT TAPE 10-INCH (WHITE) - NOT USED
9	MARKING DIAGONAL EPOXY 12-INCH (YELLOW)
10	MARKING DIAGONAL EPOXY 12-INCH (WHITE)
11	MARKING CHEVRON EPOXY 24-INCH (WHITE)
13	NOT USED
14	MARKING ARROW EPOXY (TYPE 2)
15	MARKING ARROW EPOXY (TYPE 3)
16	MARKING ARROW EPOXY (TYPE 5)
17	MARKING LINE WET REF EPOXY 10-INCH (WHITE)
18	MARKING LINE GROOVED PERMANENT TAPE 6-INCH (WHITE)
19	MARKING LINE GROOVED PERMANENT TAPE 10-INCH (WHITE)
20	MARKING LINE GROOVED PERMANENT TAPE 6-INCH (DASHED WHITE 12.5 FT LINE 37.5 FT SKIP)
21	MARKING LINE PERMANENT TAPE 6-INCH (DASHED WHITE 12.5 FT LINE 37.5 FT SKIP)
22	MARKING LINE GROOVED PERMANENT TAPE 10-INCH (DOT PATTERN WHITE) 3 FT LINE 9 FT SKIP
23	MARKING LINE EPOXY 10-INCH
24	NOT USED
25	MARKING CROSSWALK EPOXY TRANSVERSE LINE 6-INCH (DASHED WHITE 12.5 FT LINE 37.5 FT SKIP)
26	MARKING LINE GROOVED BLACK EPOXY 6-INCH (DASHED BLACK 12.5 FT LINE 37.5 FT SKIP)
27	MARKING LINE GROOVED WET REFLECTIVE EPOXY 10-INCH (WHITE)
28	MARKING LINE GROOVED PERMANENT TAPE 10-INCH (DOT PATTERN WHITE) 3 FT LINE 9 FT SKIP

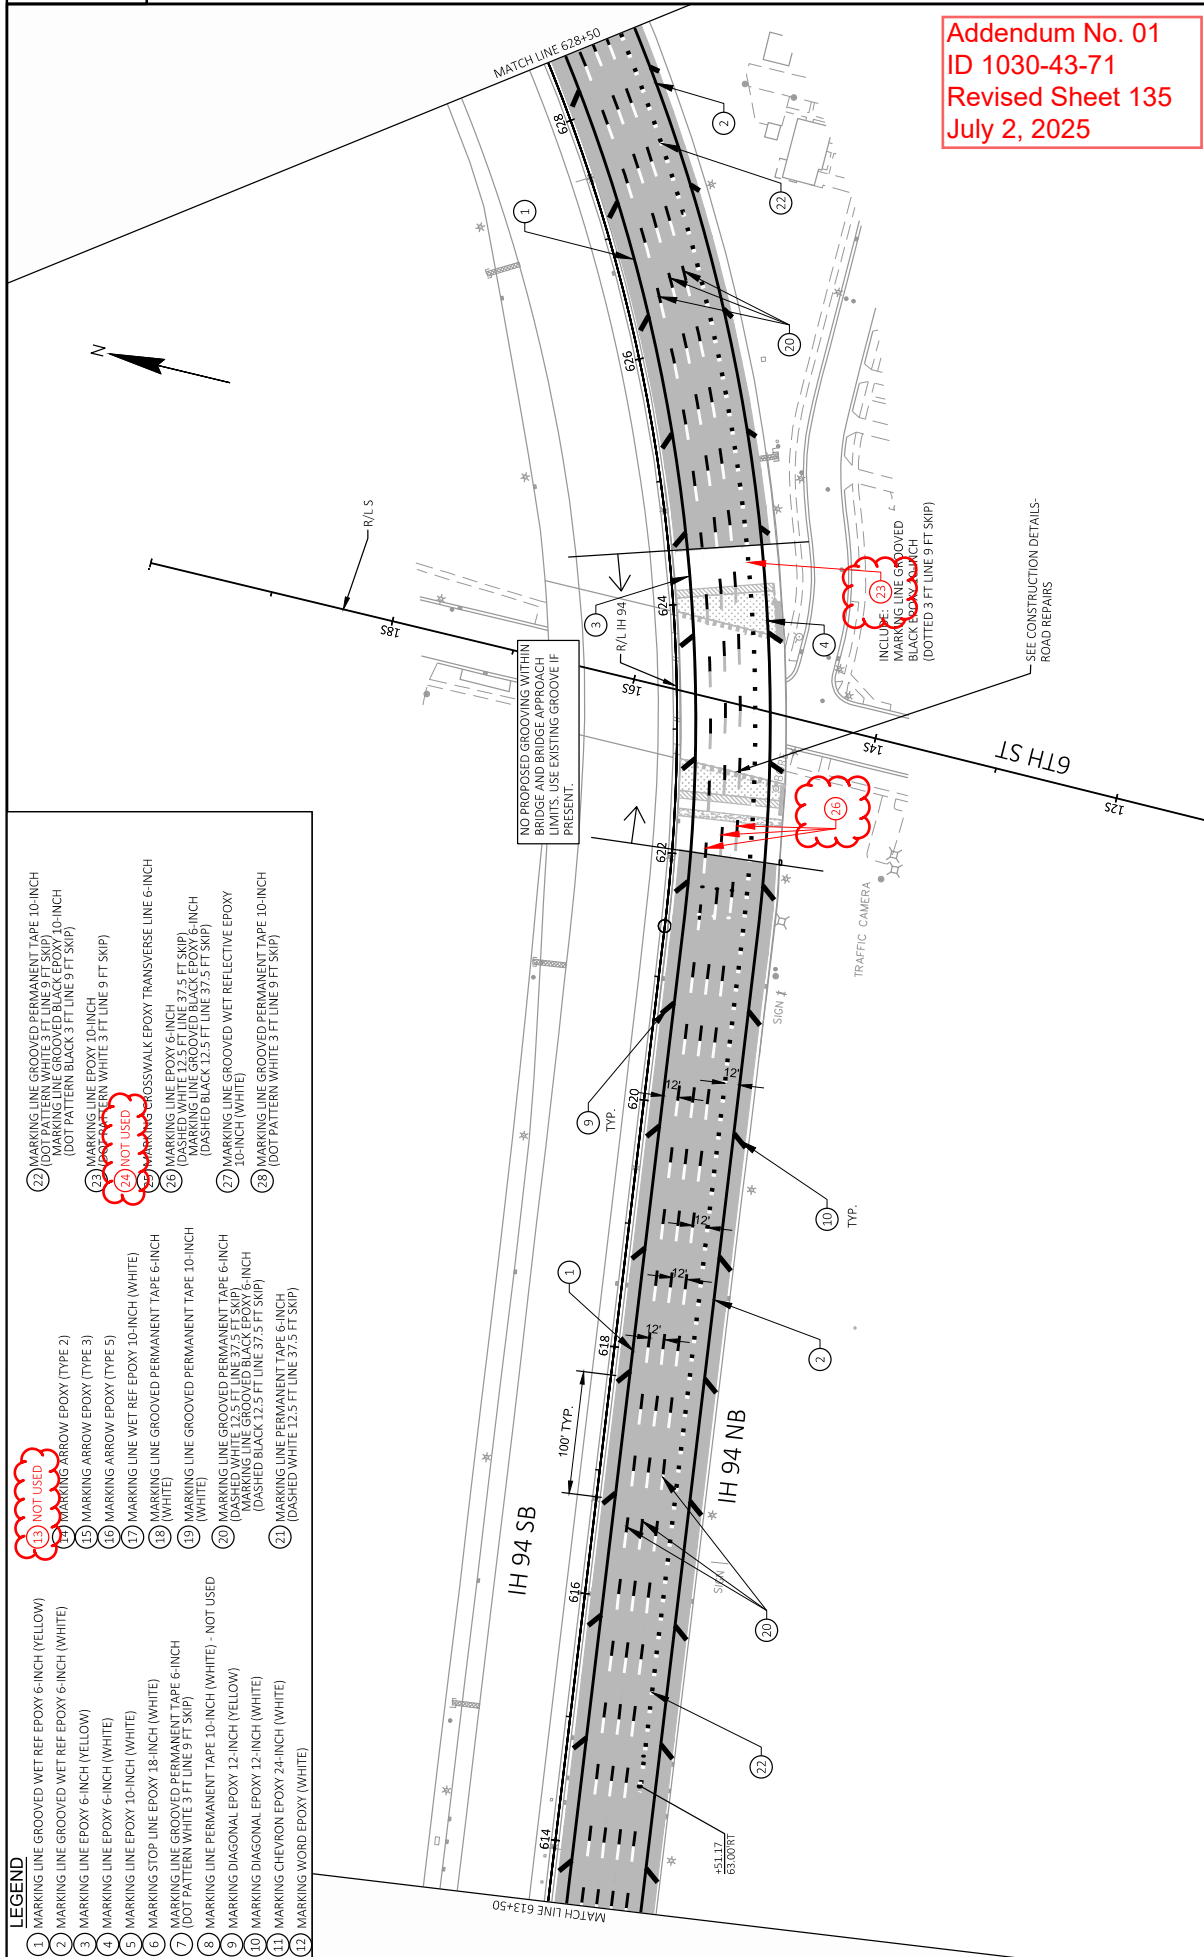

Addendum No. 01
ID 1030-43-71
Revised Sheet 135
July 2, 2025

--


- | | | | |
|----|---|--|--|
| 1 | MARKING LINE GROOVED WET REF EPOXY 6-INCH (YELLOW) | | |
| 2 | MARKING LINE GROOVED WET REF EPOXY 6-INCH (WHITE) | | |
| 4 | MARKING LINE EPOXY 6-INCH (WHITE) | | |
| 5 | MARKING LINE EPOXY 10-INCH (WHITE) | | |
| 6 | MARKING STOP LINE EPOXY 18-INCH (WHITE) | | |
| 7 | MARKING LINE GROOVED PERMANENT TAPE 6-INCH (DOT PATTERN WHITE 3 FT LINE 9 FT SKIP) | | |
| 8 | MARKING LINE PERMANENT TAPE 10-INCH (WHITE) - NOT USED | | |
| 9 | MARKING DIAGONAL EPOXY 12-INCH (YELLOW) | | |
| 10 | MARKING DIAGONAL EPOXY 12-INCH (WHITE) | | |
| 11 | MARKING CHEVRON EPOXY 24-INCH (WHITE) | | |
| 12 | MARKING WORD EPOXY (WHITE) | | |
| 13 | NOT USED | | |
| 14 | MARKING ARROW EPOXY (TYPE 2) | | |
| 15 | MARKING ARROW EPOXY (TYPE 3) | | |
| 17 | MARKING LINE WET REF EPOXY 10-INCH (WHITE) | | |
| 18 | MARKING LINE GROOVED PERMANENT TAPE 6-INCH (WHITE) | | |
| 19 | MARKING LINE GROOVED PERMANENT TAPE 10-INCH (WHITE) | | |
| 20 | MARKING LINE GROOVED PERMANENT TAPE 6-INCH (DASHED WHITE 12.5 FT LINE 37.5 FT SKIP) | | |
| 22 | MARKING LINE GROOVED PERMANENT TAPE 10-INCH (DOT PATTERN WHITE 3 FT LINE 9 FT SKIP) | | |
| 23 | MARKING LINE EPOXY 10-INCH (WHITE) | | |
| 24 | NOT USED | | |
| 26 | MARKING LINE EPOXY 6-INCH (DASHED WHITE 12.5 FT LINE 37.5 FT SKIP) | | |
| 27 | MARKING LINE GROOVED WET REFLECTIVE EPOXY 10-INCH (WHITE) | | |
| 28 | MARKING LINE GROOVED PERMANENT TAPE 10-INCH (DOT PATTERN WHITE 3 FT LINE 9 FT SKIP) | | |

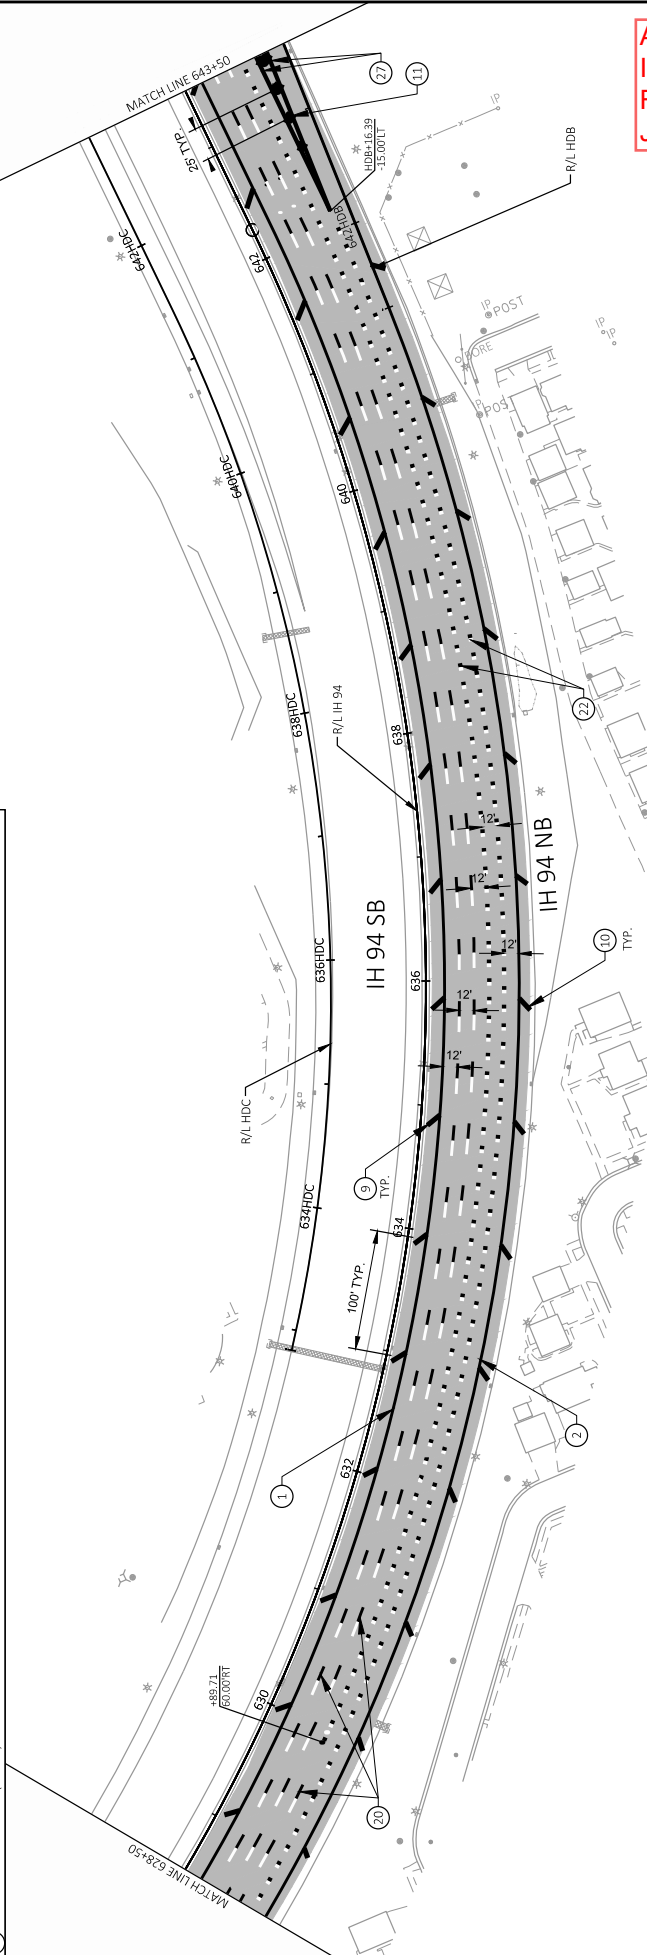

PROJECT NO:	1030-43-71	HWY:	IH 41	COUNTY:	MILWAUKEE	PAVEMENT MARKING	E
FILE NAME: X:\BM1-3715 MITCHELL INTERCHANGE\5_DESIGN\W03_ROADS\1109\43\71\SHEETPLAN\W04501.PLM DWG							
PLOT DATE: 6/24/2025 4:31 PM						PLOT BY: VALBONI,ATIFI	PLOT SCALE: 1 IN=100 FT
LAYOUT NAME: 14						SHEET 136	

--	--

-

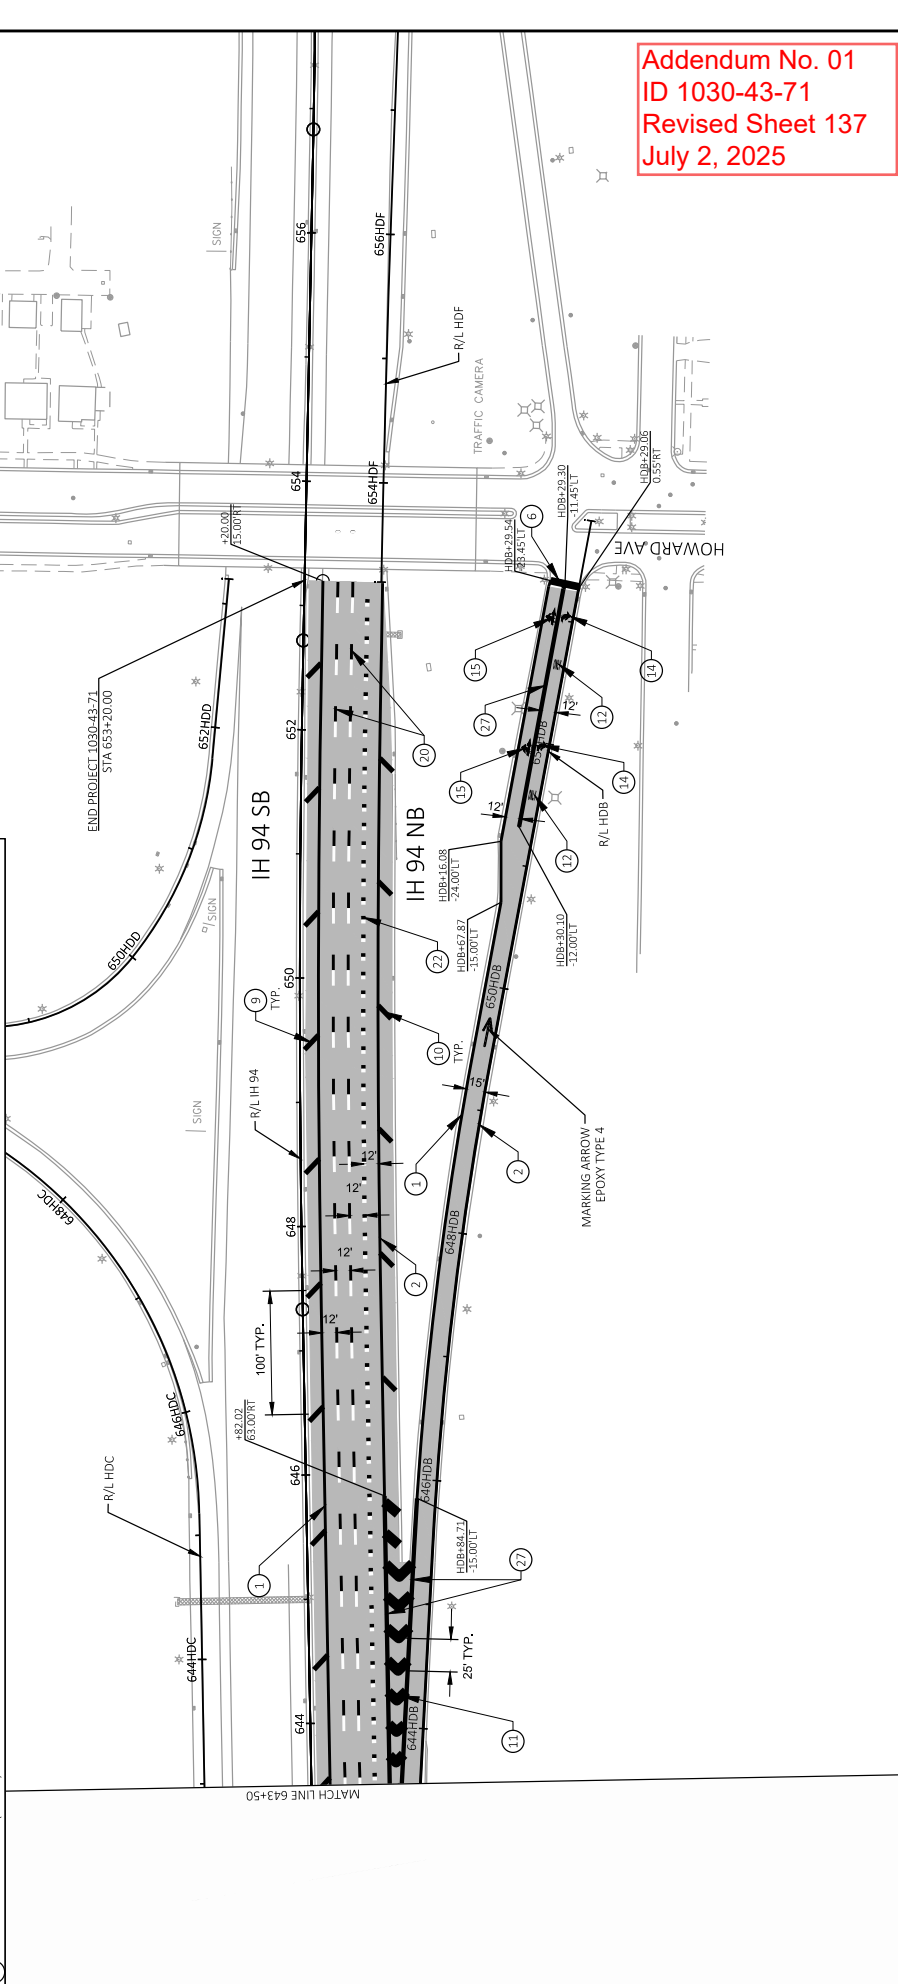

Addendum No. 01
ID 1030-43-71
Revised Sheet 137
July 2, 2025



LEGEND	
1	MARKING LINE GROOVED WET REF EPOXY 6-INCH (YELLOW)
2	MARKING LINE GROOVED WET REF EPOXY 6-INCH (WHITE)
3	MARKING LINE EPOXY 6-INCH (YELLOW)
4	MARKING LINE EPOXY 6-INCH (WHITE)
5	MARKING LINE EPOXY 10-INCH (WHITE)
6	MARKING STOP LINE EPOXY 18-INCH (WHITE)
7	MARKING LINE GROOVED PERMANENT TAPE 6-INCH (DOT PATTERN WHITE 3 FT LINE 3 FT SKP)
8	MARKING LINE PERMANENT TAPE 10-INCH (WHITE) - NOT USED
9	MARKING DIAGONAL EPOXY 12-INCH (YELLOW)
10	MARKING DIAGONAL EPOXY 12-INCH (WHITE)
11	MARKING CHEVRON EPOXY 24-INCH (WHITE)


COUNTY: MILWAUKEE	PAVEMENT MARKING
-------------------	------------------

PROJECT NO:	1030-43-71	HWY: IH 41
-------------	------------	------------


SHEET 138

PLOT NAME :

PLOT DATE:	6/24/2025 4:31 PM	PLOT BY:
------------	-------------------	----------

PLOT SCALE : 1 IN:100 FT

WIDOT/CAD/CST/1003175

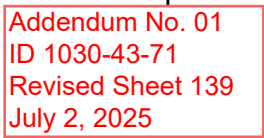

LEGEND

1. MARKING LINE GROOVED WET REF EPOXY 6-INCH (YELLOW)
2. MARKING LINE GROOVED WET REF EPOXY 6-INCH (WHITE)
3. MARKING LINE GROOVED EPOXY 6-INCH (YELLOW)
4. MARKING LINE EPOXY 6-INCH (WHITE)
5. MARKING LINE EPOXY 10-INCH (WHITE)
6. MARKING STOP LINE EPOXY 18-INCH (WHITE)
7. MARKING LINE GROOVED PERMANENT TAPE 6-INCH (DOT PATTERN WHITE 3 FT LINE 9 FT SKIP)
8. MARKING LINE PERMANENT TAPE 10-INCH (WHITE) - NOT USED
9. MARKING DIAGONAL EPOXY 12-INCH (YELLOW)
10. MARKING DIAGONAL EPOXY 12-INCH (WHITE)
11. MARKING CHEVRON EPOXY 24-INCH (WHITE)
12. MARKING STOP EPOXY (WHITE)
13. **NOT USED**
14. MARKING ARROW EPOXY (TYPE 2)
15. MARKING ARROW EPOXY (TYPE 3)
16. MARKING ARROW EPOXY (TYPE 5)
17. MARKING LINE WET REF EPOXY 10-INCH (WHITE)
18. MARKING LINE GROOVED PERMANENT TAPE 6-INCH (WHITE)
19. MARKING LINE GROOVED PERMANENT TAPE 10-INCH (WHITE)
20. MARKING LINE GROOVED PERMANENT TAPE 6-INCH (DASHED WHITE 12.5 FT LINE 37.5 FT SKIP)
(DASHED BLACK 12.5 FT LINE 37.5 FT SKIP)
21. MARKING LINE PERMANENT TAPE 6-INCH (DASHED WHITE 12.5 FT LINE 37.5 FT SKIP)
22. MARKING LINE GROOVED PERMANENT TAPE 10-INCH (DASHED WHITE 12.5 FT LINE 37.5 FT SKIP)
(DOT PATTERN BLACK 3 FT LINE 9 FT SKIP)
23. MARKING LINE EPOXY 10-INCH (DOT PATTERN WHITE 3 FT LINE 9 FT SKIP)
24. **NOT USED**
25. MARKING LINE CROSSWALK EPOXY TRANSVERSE LINE 6-INCH (WHITE)
26. MARKING LINE EPOXY 6-INCH (DASHED WHITE 12.5 FT LINE 37.5 FT SKIP)
(DASHED BLACK 12.5 FT LINE 37.5 FT SKIP)
27. MARKING LINE GROOVED WET REFLECTIVE EPOXY 10-INCH (WHITE)
28. MARKING LINE GROOVED PERMANENT TAPE 10-INCH (DOT PATTERN WHITE 3 FT LINE 9 FT SKIP)

Drawing No. 01
0-43-71
Sheet 140
2025

LEGEND

- 1 MARKING LINE GROOVED WET REF EPOXY 6-INCH (YELLOW)
- 2 MARKING LINE GROOVED WET REF EPOXY 6-INCH (WHITE)
- 3 MARKING LINE EPOXY 6-INCH (YELLOW)
- 4 MARKING LINE EPOXY 6-INCH (WHITE)
- 5 MARKING LINE EPOXY 10-INCH (WHITE)
- 6 MARKING STOP LINE EPOXY 18-INCH (WHITE)
- 7 MARKING LINE GROOVED PERMANENT TAPE 6-INCH (DOT PATTERN WHITE 3 FT LINE 9 FT SKIP)
- 8 MARKING LINE PERMANENT TAPE 10-INCH (WHITE) - NOT USED
- 9 MARKING DIAGONAL EPOXY 12-INCH (YELLOW)
- 10 MARKING DIAGONAL EPOXY 12-INCH (WHITE)
- 11 MARKING CHEVRON EPOXY 24-INCH (WHITE)
- 12 MARKING WORD EPOXY (WHITE)
- 13 NOT USED
- 14 MARKING ARROW EPOXY (TYPE 2)
- 15 MARKING ARROW EPOXY (TYPE 3)
- 16 MARKING ARROW EPOXY (TYPE 5)
- 17 MARKING LINE WET REF EPOXY 10-INCH (WHITE)
- 18 MARKING LINE GROOVED PERMANENT TAPE 6-INCH (WHITE)
- 19 MARKING LINE GROOVED PERMANENT TAPE 10-INCH (WHITE)
- 20 MARKING LINE GROOVED PERMANENT TAPE 6-INCH (DASHED WHITE 12.5 FT LINE 37.5 FT SKIP)
- 28 MARKING LINE GROOVED PERMANENT TAPE 10-INCH (DOT PATTERN WHITE 3 FT LINE 9 FT SKIP)

Construction Details:

- SEE CONSTRUCTION DETAILS - ROAD REPAIRS
- SW457.79 -40.00' LT
- TH48.06 -15.00' LT
- TH47.96 -0.00'
- SW459.26 -40.00' LT

Stationing:

- 300TA, 300TE, 302TA, 302TE, 304TA, 304TE, 306TA, 306TE, 308TA, 308TE, 310TA, 310TE, 312TA, 312TE, 314TA
- 300WS, 300WN, 302WS, 302WN, 304WS, 304WN, 306WS, 306WN, 308WS, 308WN, 310WS, 310WN, 312WS, 312WN, 314WS
- 300TH, 302TH, 304TH, 306TH, 308TH, 310TH, 312TH, 314TH


Other Labels:

- R/L TE, R/L TF, R/L SW, R/L WS, R/L TH, R/L TB, R/L WN
- MATCHLINE 299WS+00
- SIGN, GRGE, INL, SCA, SIGN, FIRE, CHIS

LEGEND

- | LEGEND | |
|--------|---|
| 1 | MARKING LINE GROOVED WET REF EPOXY 6-INCH (YELLOW) |
| 2 | MARKING LINE GROOVED WET REF EPOXY 6-INCH (WHITE) |
| 3 | MARKING LINE EPOXY 6-INCH (YELLOW) |
| 4 | MARKING LINE EPOXY 6-INCH (WHITE) |
| 5 | MARKING LINE EPOXY 10-INCH (WHITE) |
| 6 | MARKING STOP LINE EPOXY 18-INCH (WHITE) |
| 7 | MARKING LINE GROOVED PERMANENT TAPE 6-INCH (DOT PATTERN WHITE 3 FT LINE 9 FT SKIP) |
| 8 | MARKING LINE PERMANENT TAPE 10-INCH (WHITE) - NOT USED |
| 9 | MARKING DIAGONAL EPOXY 12-INCH (YELLOW) |
| 10 | MARKING DIAGONAL EPOXY 12-INCH (WHITE) |
| 11 | MARKING CHEVRON EPOXY 24-INCH (WHITE) |
| 12 | NOT USED |
| 13 | NOT USED |
| 14 | MARKING ARROW EPOXY (TYPE 2) |
| 15 | MARKING ARROW EPOXY (TYPE 3) |
| 16 | MARKING ARROW EPOXY (TYPE 5) |
| 17 | MARKING LINE WET REF EPOXY 10-INCH (WHITE) |
| 18 | MARKING LINE GROOVED PERMANENT TAPE 6-INCH (WHITE) |
| 19 | MARKING LINE GROOVED PERMANENT TAPE 10-INCH (WHITE) |
| 20 | MARKING CROSSWALK EPOXY TRANSVERSE LINE 6-INCH (WHITE) |
| 21 | MARKING LINE PERMANENT TAPE 6-INCH (DASHED WHITE 12.5 FT LINE 37.5 FT SKIP) |
| 24 | NOT USED |
| 27 | MARKING LINE GROOVED WET REFLECTIVE EPOXY 10-INCH (WHITE) |
| 28 | MARKING LINE GROOVED PERMANENT TAPE 10-INCH (DOT PATTERN WHITE 3 FT LINE 9 FT SKIP) |

PROJECT NO: 1030-43-71		HWY: IH 41	COUNTY: MILWAUKEE	PAVEMENT MARKING	SHEET 140	E
FILE NAME: X:\B01-2718\INTERCHANGE\5_DESIGN\3_ROADS\03043001\SHEETS\PLAN\024501.PDWG		PLOT DATE: 6/24/2025 4:31 PM		PLOT BY: VALERON LATIFI	PLOT SCALE: 1 IN.=100 FT	
LAYOUT NAME: 18		WISDOT/CADDIS SHEET 42				

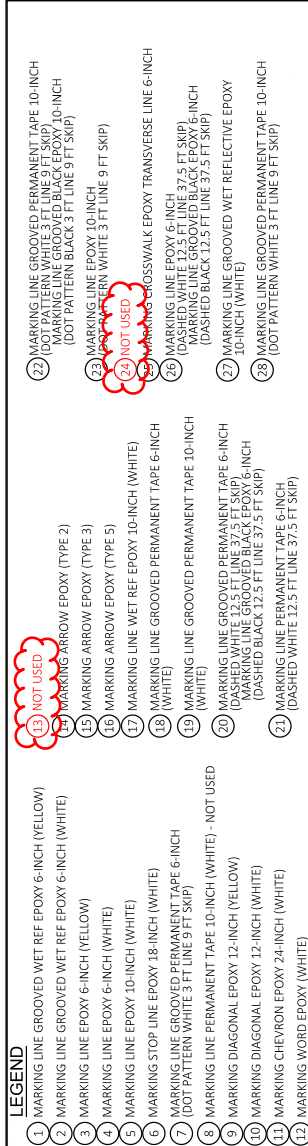

LEGEND

- (1) MARKING LINE GROOVED WET REF EPOXY 6-INCH (YELLOW)
- (2) MARKING LINE GROOVED WET REF EPOXY 6-INCH (WHITE)
- (3) MARKING LINE EPOXY 6-INCH (YELLOW)
- (4) MARKING LINE EPOXY 6-INCH (WHITE)
- (5) MARKING LINE EPOXY 10-INCH (WHITE)
- (6) MARKING STOP LINE EPOXY 18-INCH (WHITE)
- (7) MARKING LINE GROOVED PERMANENT TAPE 6-INCH
(DOT PATTERN WHITE 3 FT LINE 9 FT SKIP)
- (8) MARKING LINE PERMANENT TAPE 10-INCH (WHITE) - NOT USED
- (9) MARKING DIAGONAL EPOXY 12-INCH (YELLOW)
- (10) MARKING DIAGONAL EPOXY 12-INCH (WHITE)
- (11) MARKING CHEVRON EPOXY 24-INCH (WHITE)
- (12) MARKING WORD EPOXY (WHITE)
- (13) **NOT USED**
- (14) MARKING ARROW EPOXY (TYPE 2)
- (15) MARKING ARROW EPOXY (TYPE 3)
- (16) MARKING ARROW EPOXY (TYPE 5)
- (17) MARKING LINE WET REF EPOXY 10-INCH (WHITE)
(WHITE)
- (18) MARKING LINE GROOVED PERMANENT TAPE 6-INCH
(WHITE)
- (19) MARKING LINE GROOVED PERMANENT TAPE 10-INCH
(WHITE)
- (20) MARKING LINE GROOVED PERMANENT TAPE 6-INCH
(DASHED WHITE 12.5 FT LINE 37.5 FT SKIP)
(MARKING LINE GROOVED BLACK EPOXY 6-INCH
(DASHED BLACK 12.5 FT LINE 37.5 FT SKIP))
- (21) MARKING LINE PERMANENT TAPE 6-INCH
(DASHED WHITE 12.5 FT LINE 37.5 FT SKIP)
- (28) MARKING LINE GROOVED PERMANENT TAPE 10-INCH
(DOT PATTERN WHITE 3 FT LINE 9 FT SKIP)

SEE 1030-43-72 PLANS FOR MARKINGS IN THIS AREA

S. 20TH STREET

IH 894 WB*

IH 894 EB

MATCHLINE 314WS+00

MATCHLINE 327WN+00

R/L TW

R/L WS

R/L WN

R/L TB

NW+83.60
SW+80.04
NW+80.93
SW+80.01














TYP.

SIGN

INL

SEE CONSTRUCTION DETAILS ROAD REPAIRS

Addendum No. 01
ID 1030-43-71
Revised Sheet 142
July 2, 2025

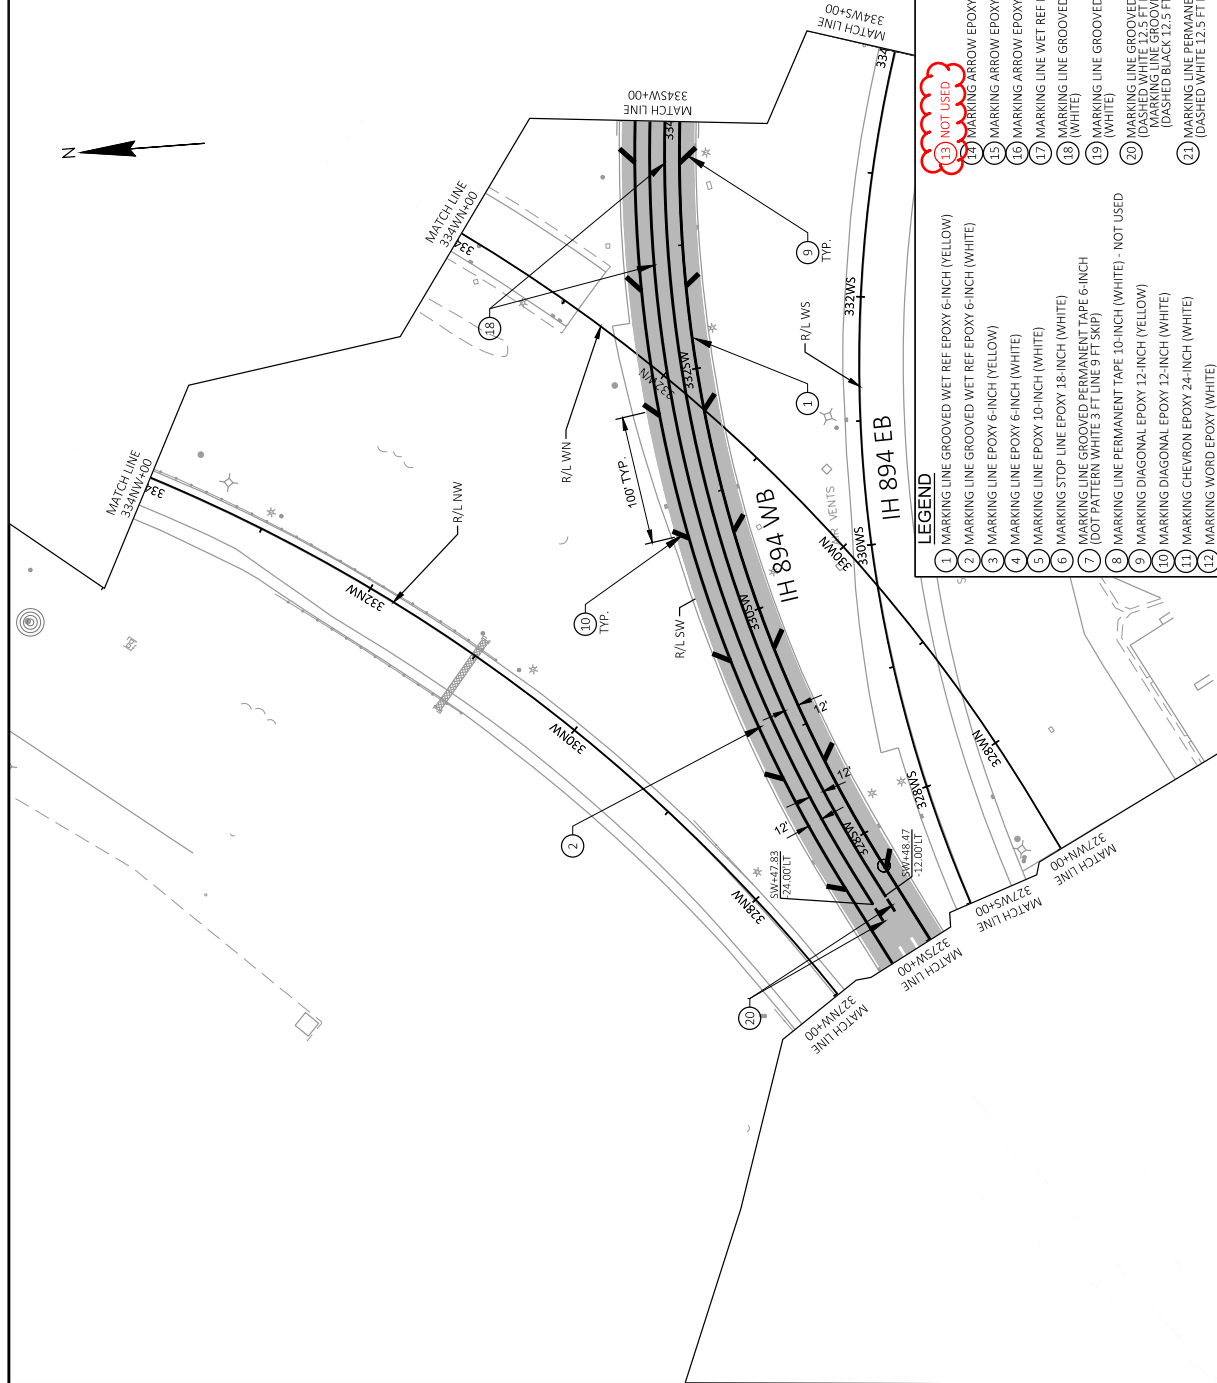

LEGEND


- | | | |
|--|---|---|
| 1 MARKING LINE GROOVED WET REF EPOXY 6-INCH (YELLOW) | 13 NOT USED | 22 MARKING LINE GROOVED PERMANENT TAPE 10-INCH (DOT PATTERN WHITE 3 FT LINE 9 FT SKIP) |
| 2 MARKING LINE GROOVED WET REF EPOXY 6-INCH (WHITE) | 14 MARKING ARROW EPOXY (TYPE 2) | 23 MARKING LINE EPOXY 10-INCH (DOT PATTERN BLACK 3 FT LINE 9 FT SKIP) |
| 3 MARKING LINE EPOXY 6-INCH (YELLOW) | 15 MARKING ARROW EPOXY (TYPE 3) | 24 NOT USED |
| 4 MARKING LINE EPOXY 6-INCH (WHITE) | 16 MARKING ARROW EPOXY (TYPE 5) | 25 MARKING CROSSWALK EPOXY TRANSVERSE LINE 6-INCH (DOT PATTERN WHITE 3 FT LINE 9 FT SKIP) |
| 5 MARKING LINE EPOXY 10-INCH (WHITE) | 17 MARKING LINE WET REF EPOXY 10-INCH (WHITE) | 26 MARKING LINE EPOXY 6-INCH (DASHED WHITE 12.5 FT LINE 37.5 FT SKIP) |
| 6 MARKING STOP LINE EPOXY 18-INCH (WHITE) | 18 MARKING LINE GROOVED PERMANENT TAPE 6-INCH (WHITE) | 27 MARKING LINE GROOVED BLACK EPOXY 6-INCH (DASHED BLACK 12.5 FT LINE 37.5 FT SKIP) |
| 7 MARKING LINE GROOVED PERMANENT TAPE 6-INCH (DOT PATTERN WHITE 3 FT LINE 9 FT SKIP) | 19 MARKING LINE GROOVED PERMANENT TAPE 10-INCH (WHITE) | 28 MARKING LINE GROOVED WET REFLECTIVE EPOXY 10-INCH (WHITE) |
| 8 MARKING LINE PERMANENT TAPE 10-INCH (WHITE) - NOT USED | 20 MARKING LINE GROOVED PERMANENT TAPE 10-INCH (DASHED WHITE 12.5 FT LINE 37.5 FT SKIP) | |
| 9 MARKING DIAGONAL EPOXY 12-INCH (YELLOW) | 21 MARKING LINE GROOVED BLACK EPOXY 6-INCH (DASHED BLACK 12.5 FT LINE 37.5 FT SKIP) | |
| 10 MARKING DIAGONAL EPOXY 12-INCH (WHITE) | | |
| 11 MARKING CHEVRON EPOXY 24-INCH (WHITE) | | |
| 12 MARKING WORD EPOXY (WHITE) | | |

LEGEND

- 1 MARKING LINE GROOVED WET REF EPOXY 6-INCH (YELLOW)
- 2 MARKING LINE GROOVED WET REF EPOXY 6-INCH (WHITE)
- 3 MARKING LINE EPOXY 6-INCH (YELLOW)
- 4 MARKING LINE EPOXY 6-INCH (WHITE)
- 5 MARKING LINE EPOXY 10-INCH (WHITE)
- 6 MARKING STOP LINE EPOXY 18-INCH (WHITE)
- 7 MARKING LINE GROOVED PERMANENT TAPE 6-INCH (DOT PATTERN WHITE 3 FT LINE 9 FT SKIP)
- 8 MARKING LINE PERMANENT TAPE 10-INCH (WHITE) - NOT USED
- 9 MARKING DIAGONAL EPOXY 12-INCH (YELLOW)
- 10 MARKING DIAGONAL EPOXY 12-INCH (WHITE)
- 11 MARKING CHEVRON EPOXY 24-INCH (WHITE)
- 12 MARKING WORD EPOXY (WHITE)

- 13 NOT USED
- 14 MARKING ARROW EPOXY (TYPE 2)
- 15 MARKING ARROW EPOXY (TYPE 3)
- 16 MARKING ARROW EPOXY (TYPE 5)
- 17 MARKING LINE WET REF EPOXY 10-INCH (WHITE)
- 18 MARKING LINE GROOVED PERMANENT TAPE 6-INCH (WHITE)
- 19 MARKING LINE GROOVED PERMANENT TAPE 10-INCH (WHITE)
- 20 MARKING LINE GROOVED PERMANENT TAPE 6-INCH (DASHED WHITE 12.5 FT LINE 37.5 FT SKIP)
- 21 MARKING LINE PERMANENT TAPE 6-INCH (DASHED WHITE 12.5 FT LINE 37.5 FT SKIP)

- 22 MARKING LINE GROOVED PERMANENT TAPE 10-INCH (DOT PATTERN WHITE 3 FT LINE 9 FT SKIP)
- 23 MARKING LINE GROOVED BLACK EPOXY 10-INCH (DOT PATTERN BLACK 3 FT LINE 9 FT SKIP)
- 24 NOT USED
- 25 MARKING CROSSWALK EPOXY TRANSVERSE LINE 6-INCH
- 26 MARKING LINE EPOXY 6-INCH (DASHED WHITE 12.5 FT LINE 37.5 FT SKIP)

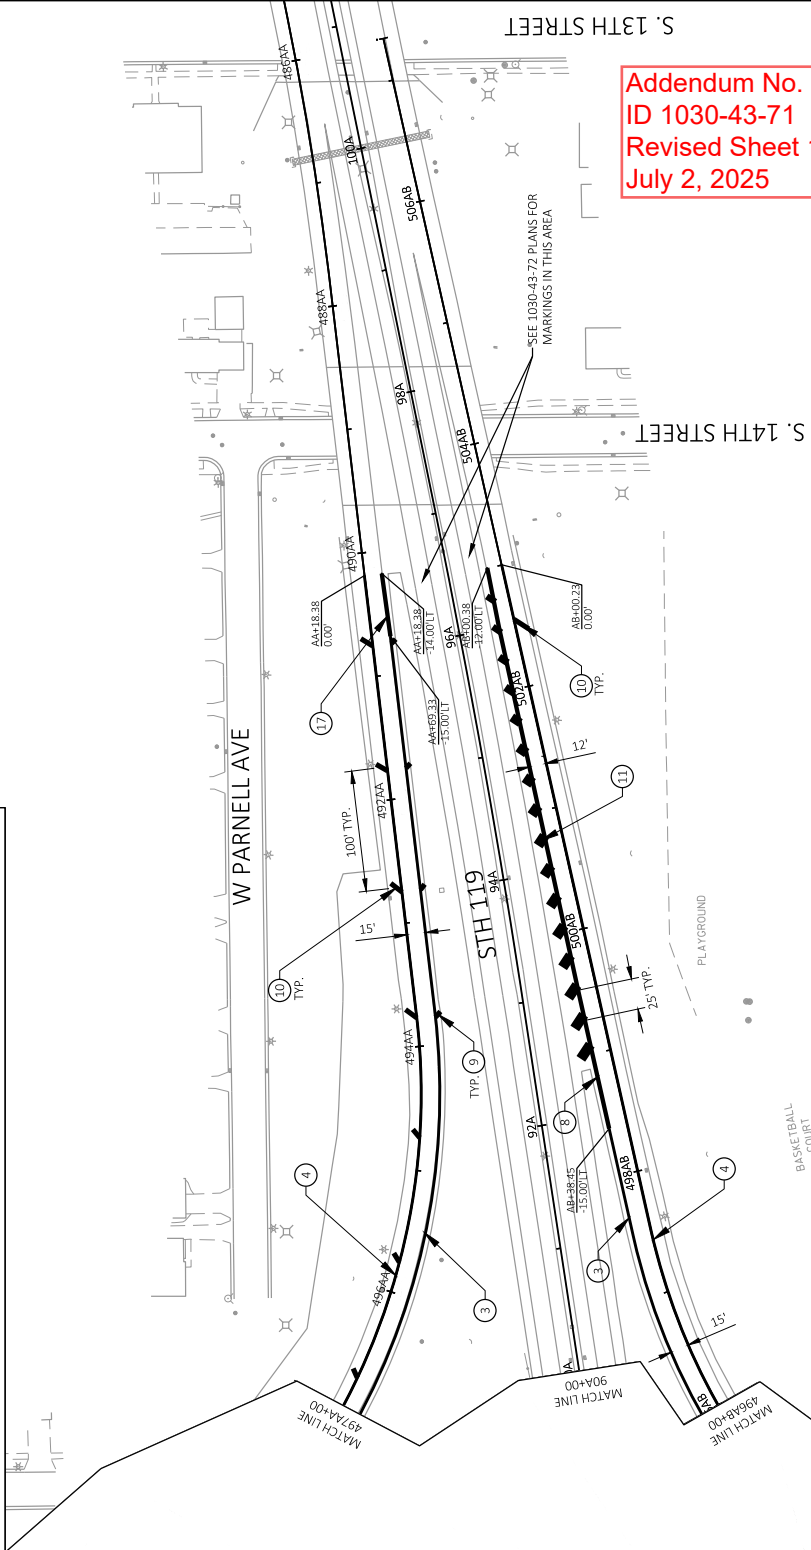

PROJECT NO: 1030-43-71	HWY: IH 41	COUNTY: MILWAUKEE	PAVEMENT MARKING	SHEET 143	E
FILE NAME: X:\BM\3719 MITCHELL INTERCHANGE\DESIGN\03_ROADS\10304371\10304371-PA.DWG	LAYOUT NAME: 21	6/24/2025 4:32 PM	6/24/2025 4:32 PM	1 IN=100 FT	WISDOT/CDDIS SHEET 143


3

3


FILE NAME : X:\BM1-3719_Mitchell Interchange\5_Design\03_Roads\03040301\Sheet\Plan\032001-mq.pptx
PLOT DATE : 6/26/2025 14:44:28
PLOT BY : BLOOM COMPANIES
PLOT NAME :
PLOT SCALE : 1:1

PAVEMENT MARKING ITEMS CONTINUED

PROJECT NO: 1030-43-71	Hwy: IH 41	COUNTY: MILWAUKEE	MISCELLANEOUS QUANTITIES	PLOT NAME: PLOT SCALE: 1" = 1'	SHEET: 327	E
------------------------	------------	-------------------	--------------------------	--------------------------------	------------	---

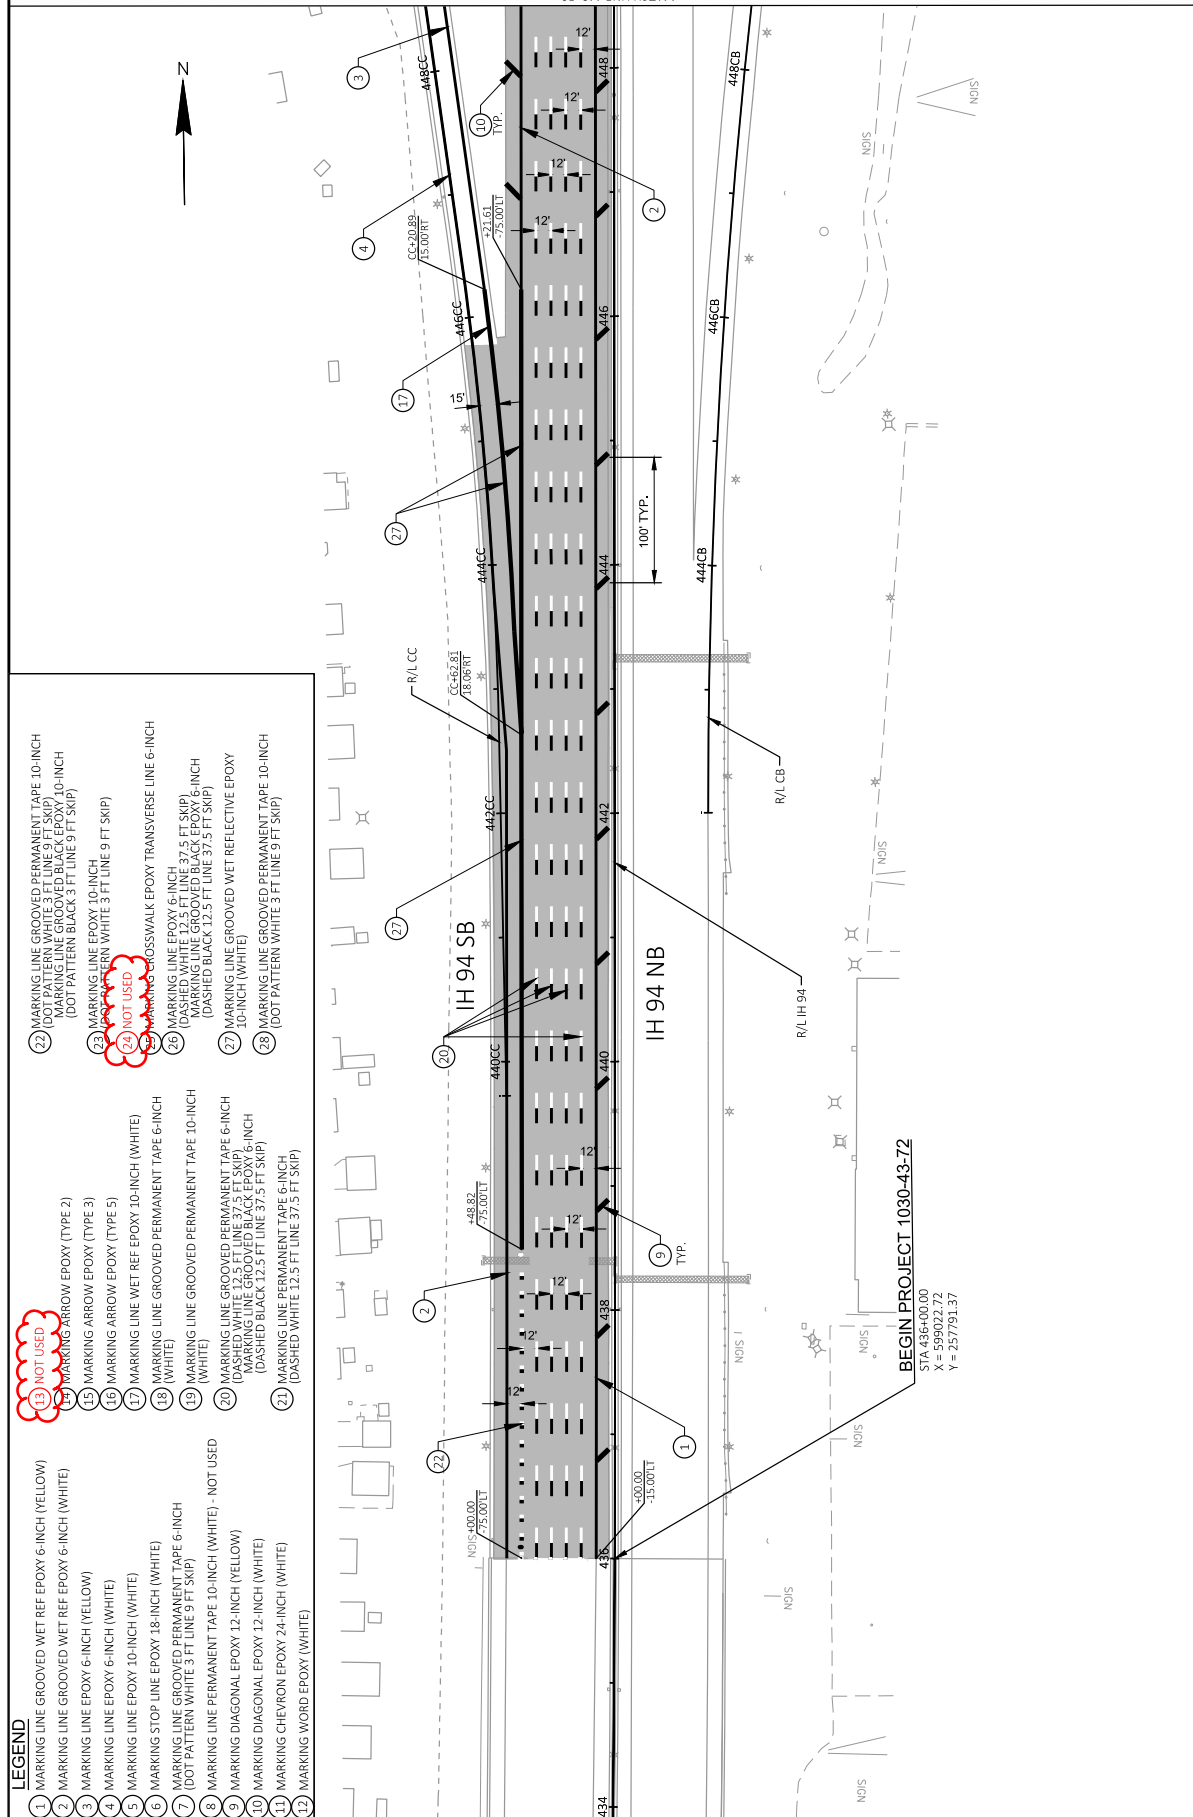


Addendum No. 01
ID 1030-43-72
Revised Sheet 149
July 2, 2025

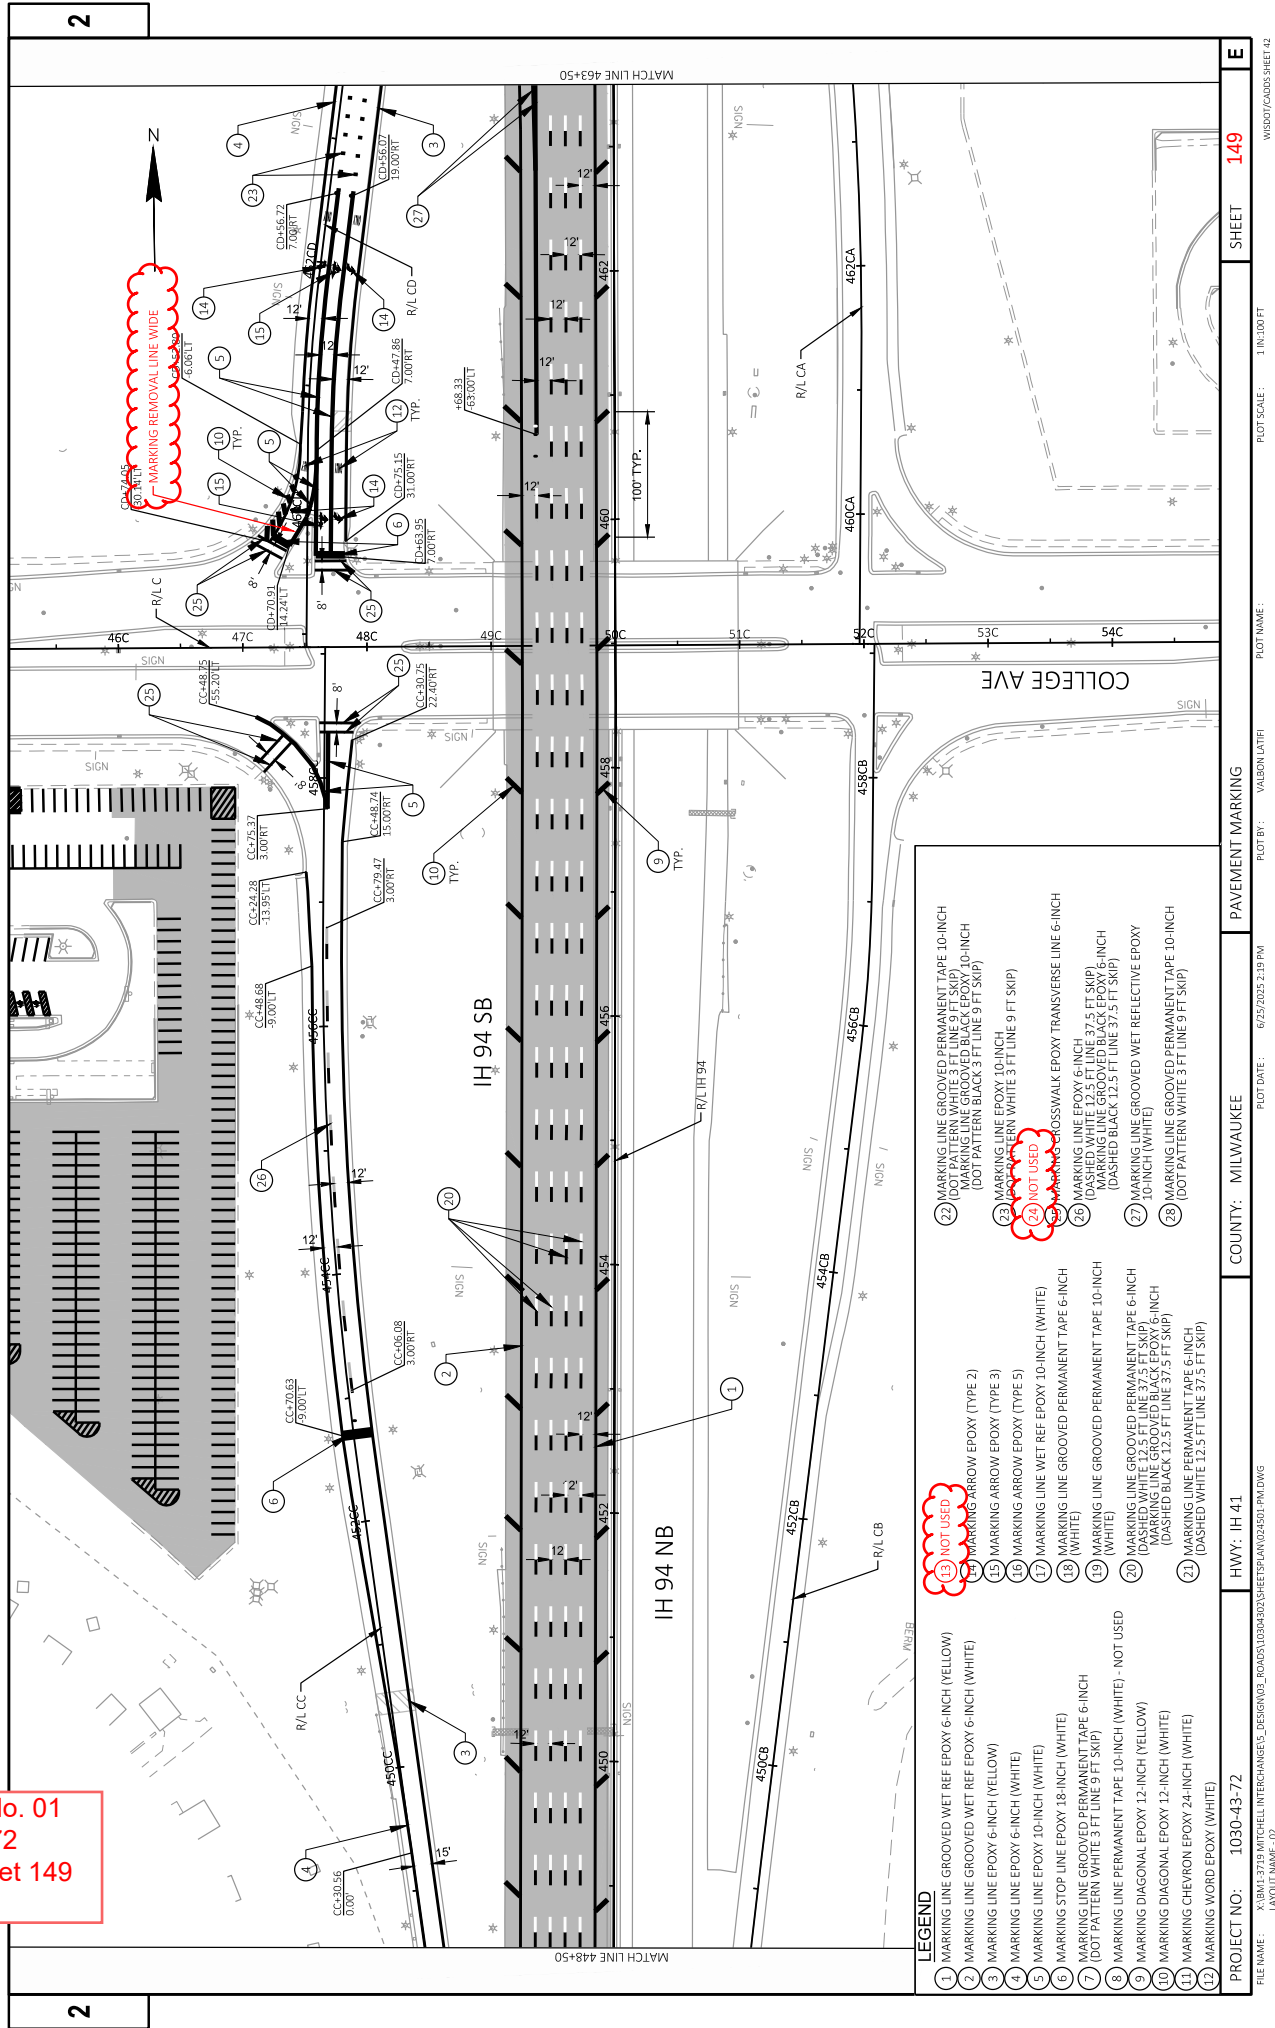

- LEGEND**
- 1 MARKING LINE GROOVED WET REF EPOXY 6-INCH (YELLOW)
 - 2 MARKING LINE GROOVED WET REF EPOXY 6-INCH (WHITE)
 - 3 MARKING LINE EPOXY 6-INCH (YELLOW)
 - 4 MARKING LINE EPOXY 6-INCH (WHITE)
 - 5 MARKING STOP LINE EPOXY 18-INCH (WHITE)
 - 6 MARKING LINE GROOVED PERMANENT TAPE 6-INCH (WHITE)
 - 8 MARKING LINE PERMANENT TAPE 10-INCH (WHITE) - NOT USED
 - 9 MARKING DIAGONAL EPOXY 12-INCH (YELLOW)
 - 10 MARKING DIAGONAL EPOXY 12-INCH (WHITE)
 - 11 MARKING CHEVRON EPOXY 24-INCH (WHITE)
 - 12 MARKING WORD EPOXY (WHITE)
 - 13 **NOT USED**
 - 14 MARKING ARROW EPOXY (TYPE 2)
 - 15 MARKING ARROW EPOXY (TYPE 3)
 - 16 MARKING ARROW EPOXY (TYPE 5)
 - 17 MARKING LINE WET REF EPOXY 10-INCH (WHITE)
 - 18 MARKING LINE GROOVED PERMANENT TAPE 6-INCH (WHITE)
 - 19 MARKING LINE GROOVED PERMANENT TAPE 10-INCH (WHITE)
 - 20 MARKING LINE GROOVED PERMANENT TAPE 6-INCH (DASHED WHITE 12.5 FT LINE 37.5 FT SKIP)
 - 22 MARKING LINE GROOVED PERMANENT TAPE 10-INCH (DOT PATTERN WHITE 3 FT LINE 9 FT SKIP)
 - 23 MARKING LINE EPOXY 10-INCH (DOT PATTERN WHITE 3 FT LINE 9 FT SKIP)
 - 24 **NOT USED**
 - 25 MARKING LINE CROSSWALK EPOXY TRANSVERSE LINE 6-INCH (DASHED WHITE 12.5 FT LINE 37.5 FT SKIP)
 - 26 MARKING LINE EPOXY 6-INCH (DASHED WHITE 12.5 FT LINE 37.5 FT SKIP)
 - 27 MARKING LINE GROOVED WET REFLECTIVE EPOXY 10-INCH (WHITE)
 - 28 MARKING LINE GROOVED PERMANENT TAPE 10-INCH (DOT PATTERN WHITE 3 FT LINE 9 FT SKIP)

Addendum No. 01
ID 1030-43-72
Revised Sheet 150
July 2, 2025

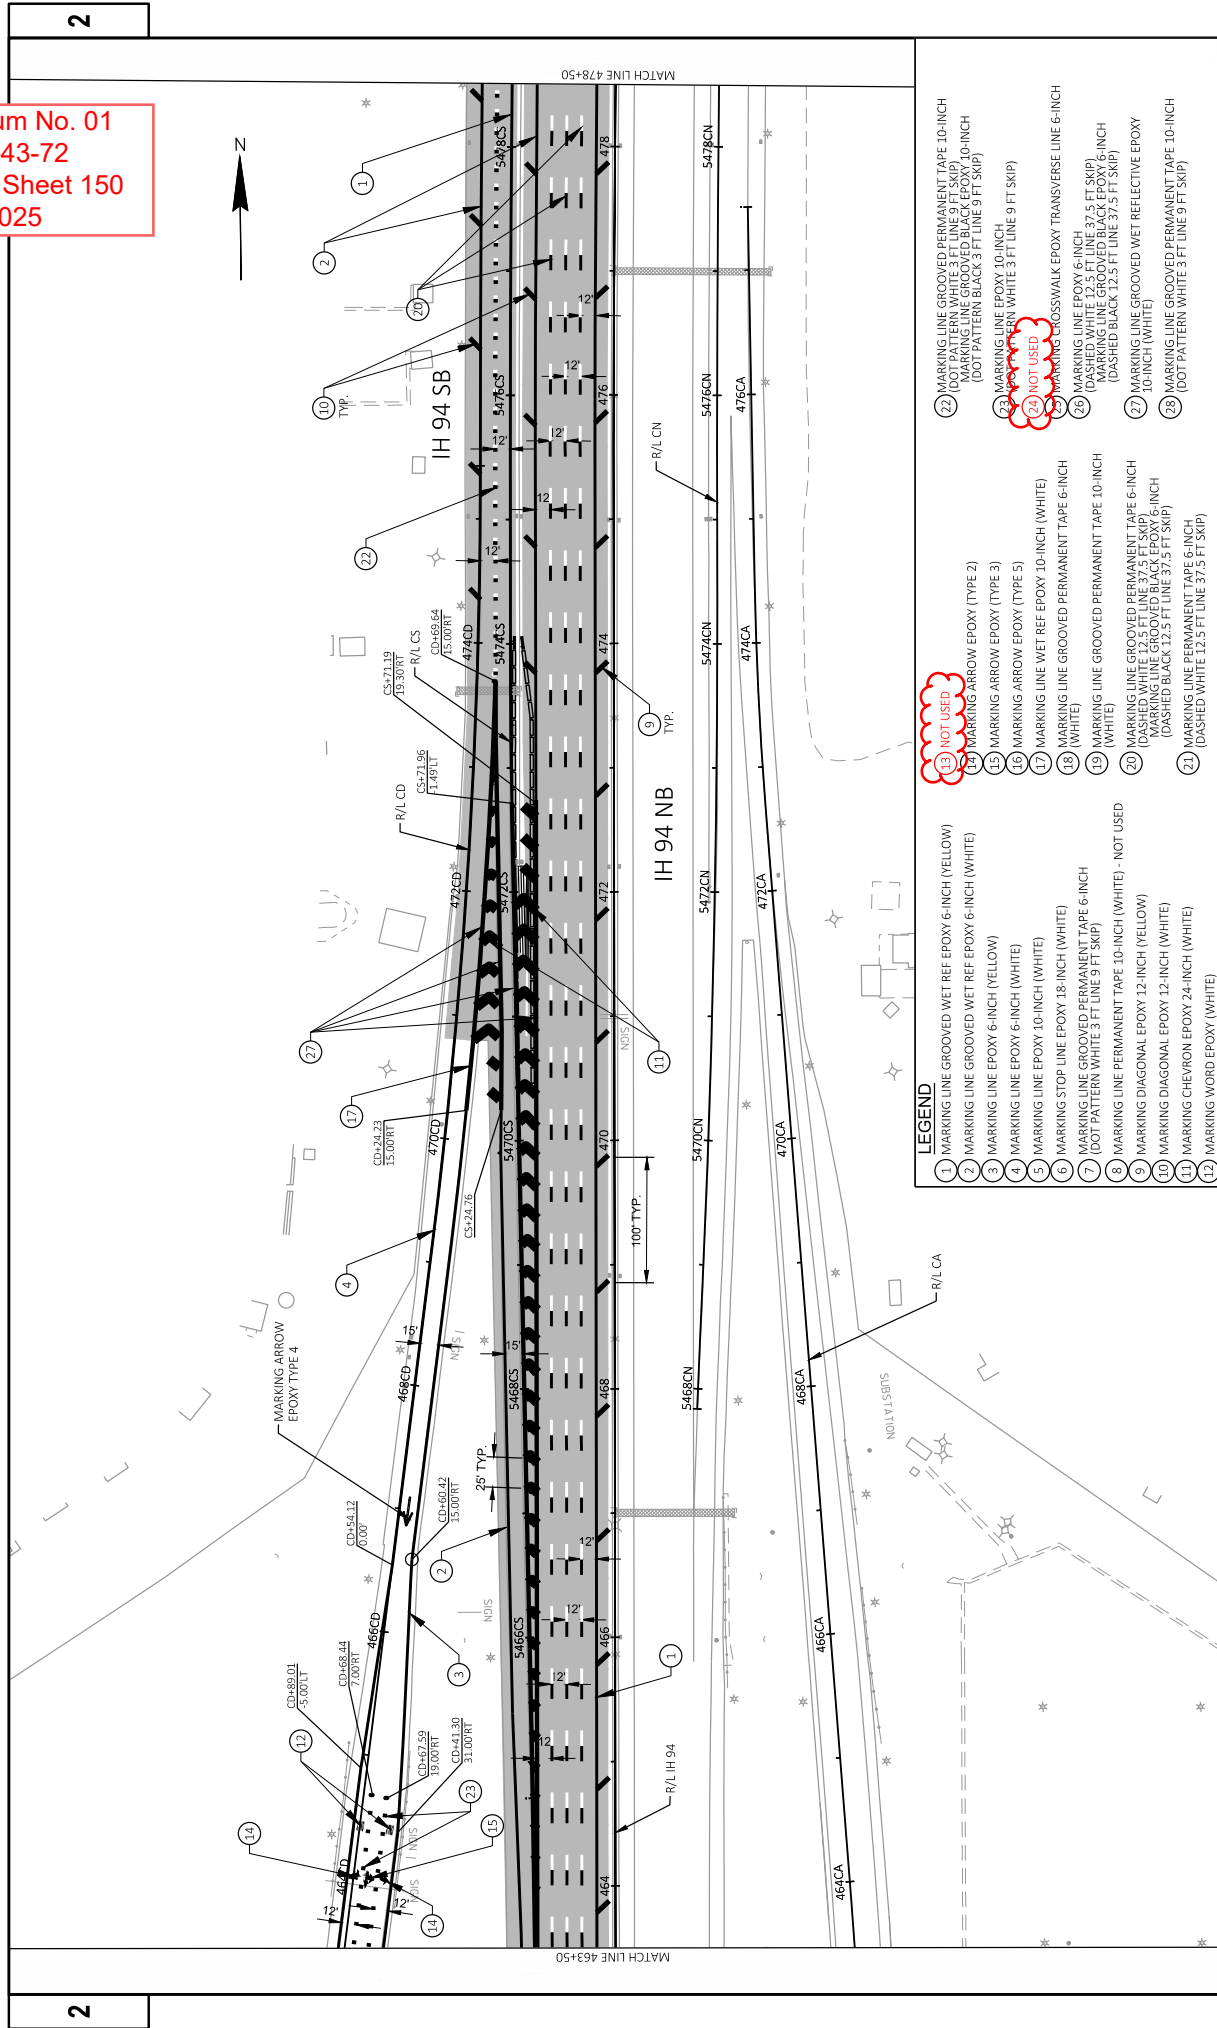


LEGEND


- 1 MARKING LINE GROOVED WET REF EPOXY 6-INCH (YELLOW)
- 2 MARKING LINE GROOVED WET REF EPOXY 6-INCH (WHITE)
- 3 MARKING LINE EPOXY 6-INCH (YELLOW)
- 4 MARKING LINE EPOXY 6-INCH (WHITE)
- 5 MARKING STOP LINE EPOXY 18-INCH (WHITE)

LEGEND

- | LEGEND | |
|--------|---|
| 1 | MARKING LINE GROOVED WET REF EPOXY 6-INCH (YELLOW) |
| 2 | MARKING LINE GROOVED WET REF EPOXY 6-INCH (WHITE) |
| 3 | MARKING LINE EPOXY 6-INCH (YELLOW) |
| 4 | MARKING LINE EPOXY 6-INCH (WHITE) |
| 5 | MARKING LINE EPOXY 10-INCH (WHITE) |
| 6 | MARKING STOP LINE EPOXY 18-INCH (WHITE) |
| 7 | MARKING LINE GROOVED PERMANENT TAPE 6-INCH (DOT PATTERN WHITE 3 FT LINE 3 FT SKIP) |
| 8 | MARKING LINE PERMANENT TAPE 10-INCH (WHITE) - NOT USED |
| 9 | MARKING DIAGONAL EPOXY 12-INCH (YELLOW) |
| 10 | MARKING DIAGONAL EPOXY 12-INCH (WHITE) |
| 11 | MARKING CHEVRON EPOXY 24-INCH (WHITE) |
| 12 | MARKING WORD EPOXY (WHITE) |
| 13 | NOT USED |
| 14 | MARKING ARROW EPOXY (TYPE 2) |
| 15 | MARKING ARROW EPOXY (TYPE 3) |
| 16 | MARKING ARROW EPOXY (TYPE 5) |
| 17 | MARKING LINE WET REF EPOXY 10-INCH (WHITE) |
| 18 | MARKING LINE GROOVED PERMANENT TAPE 6-INCH (WHITE) |
| 19 | MARKING LINE GROOVED PERMANENT TAPE 10-INCH (WHITE) |
| 20 | MARKING LINE GROOVED PERMANENT TAPE 6-INCH (DASHED WHITE 12.5 FT LINE 37.5 FT SKIP) |
| 21 | MARKING LINE PERMANENT TAPE 6-INCH (DASHED WHITE 12.5 FT LINE 37.5 FT SKIP) |
| 22 | MARKING LINE GROOVED PERMANENT TAPE 10-INCH (DOT PATTERN WHITE 3 FT LINE 9 FT SKIP) |
| 23 | MARKING LINE GROOVED BLACK EPOXY 10-INCH (DOT PATTERN BLACK 3 FT LINE 9 FT SKIP) |
| 24 | NOT USED |
| 25 | MARKING LINE EPOXY 10-INCH (DOT PATTERN WHITE 3 FT LINE 9 FT SKIP) |
| 26 | MARKING LINE GROOVED PERMANENT TAPE 6-INCH (DASHED WHITE 12.5 FT LINE 37.5 FT SKIP) |
| 27 | MARKING LINE GROOVED WET REFLECTIVE EPOXY 10-INCH (WHITE) |
| 28 | MARKING LINE GROOVED PERMANENT TAPE 10-INCH (DOT PATTERN WHITE 3 FT LINE 9 FT SKIP) |

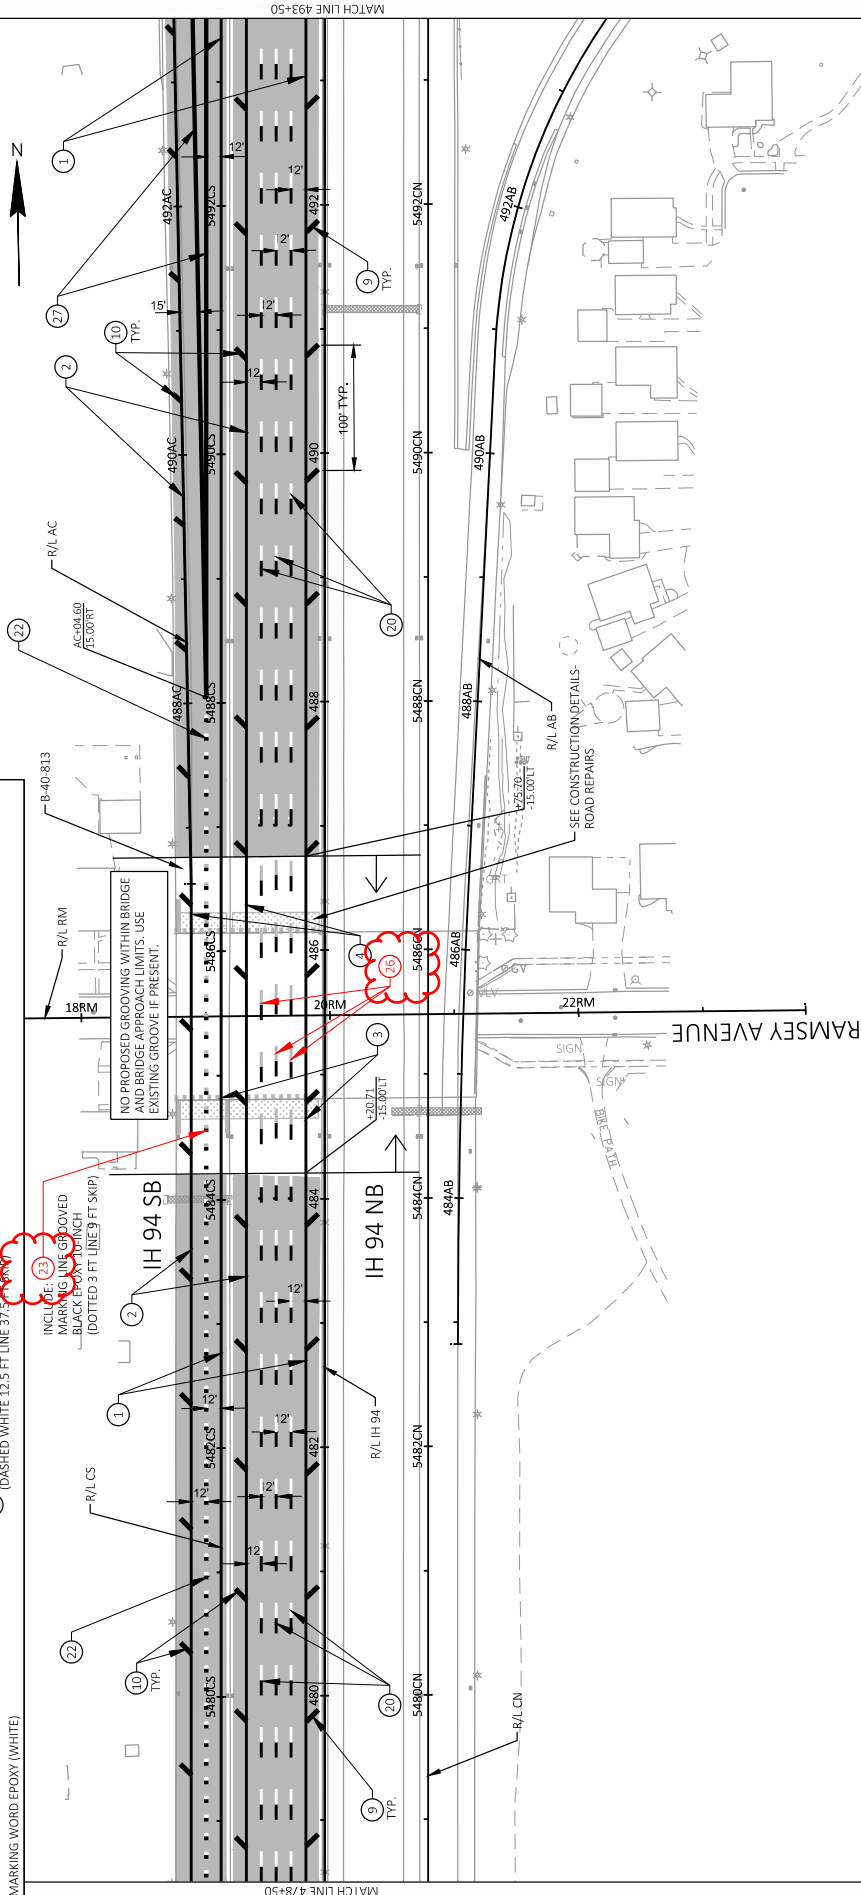


Addendum No. 01
ID 1030-43-72
Revised Sheet 152
July 2, 2025

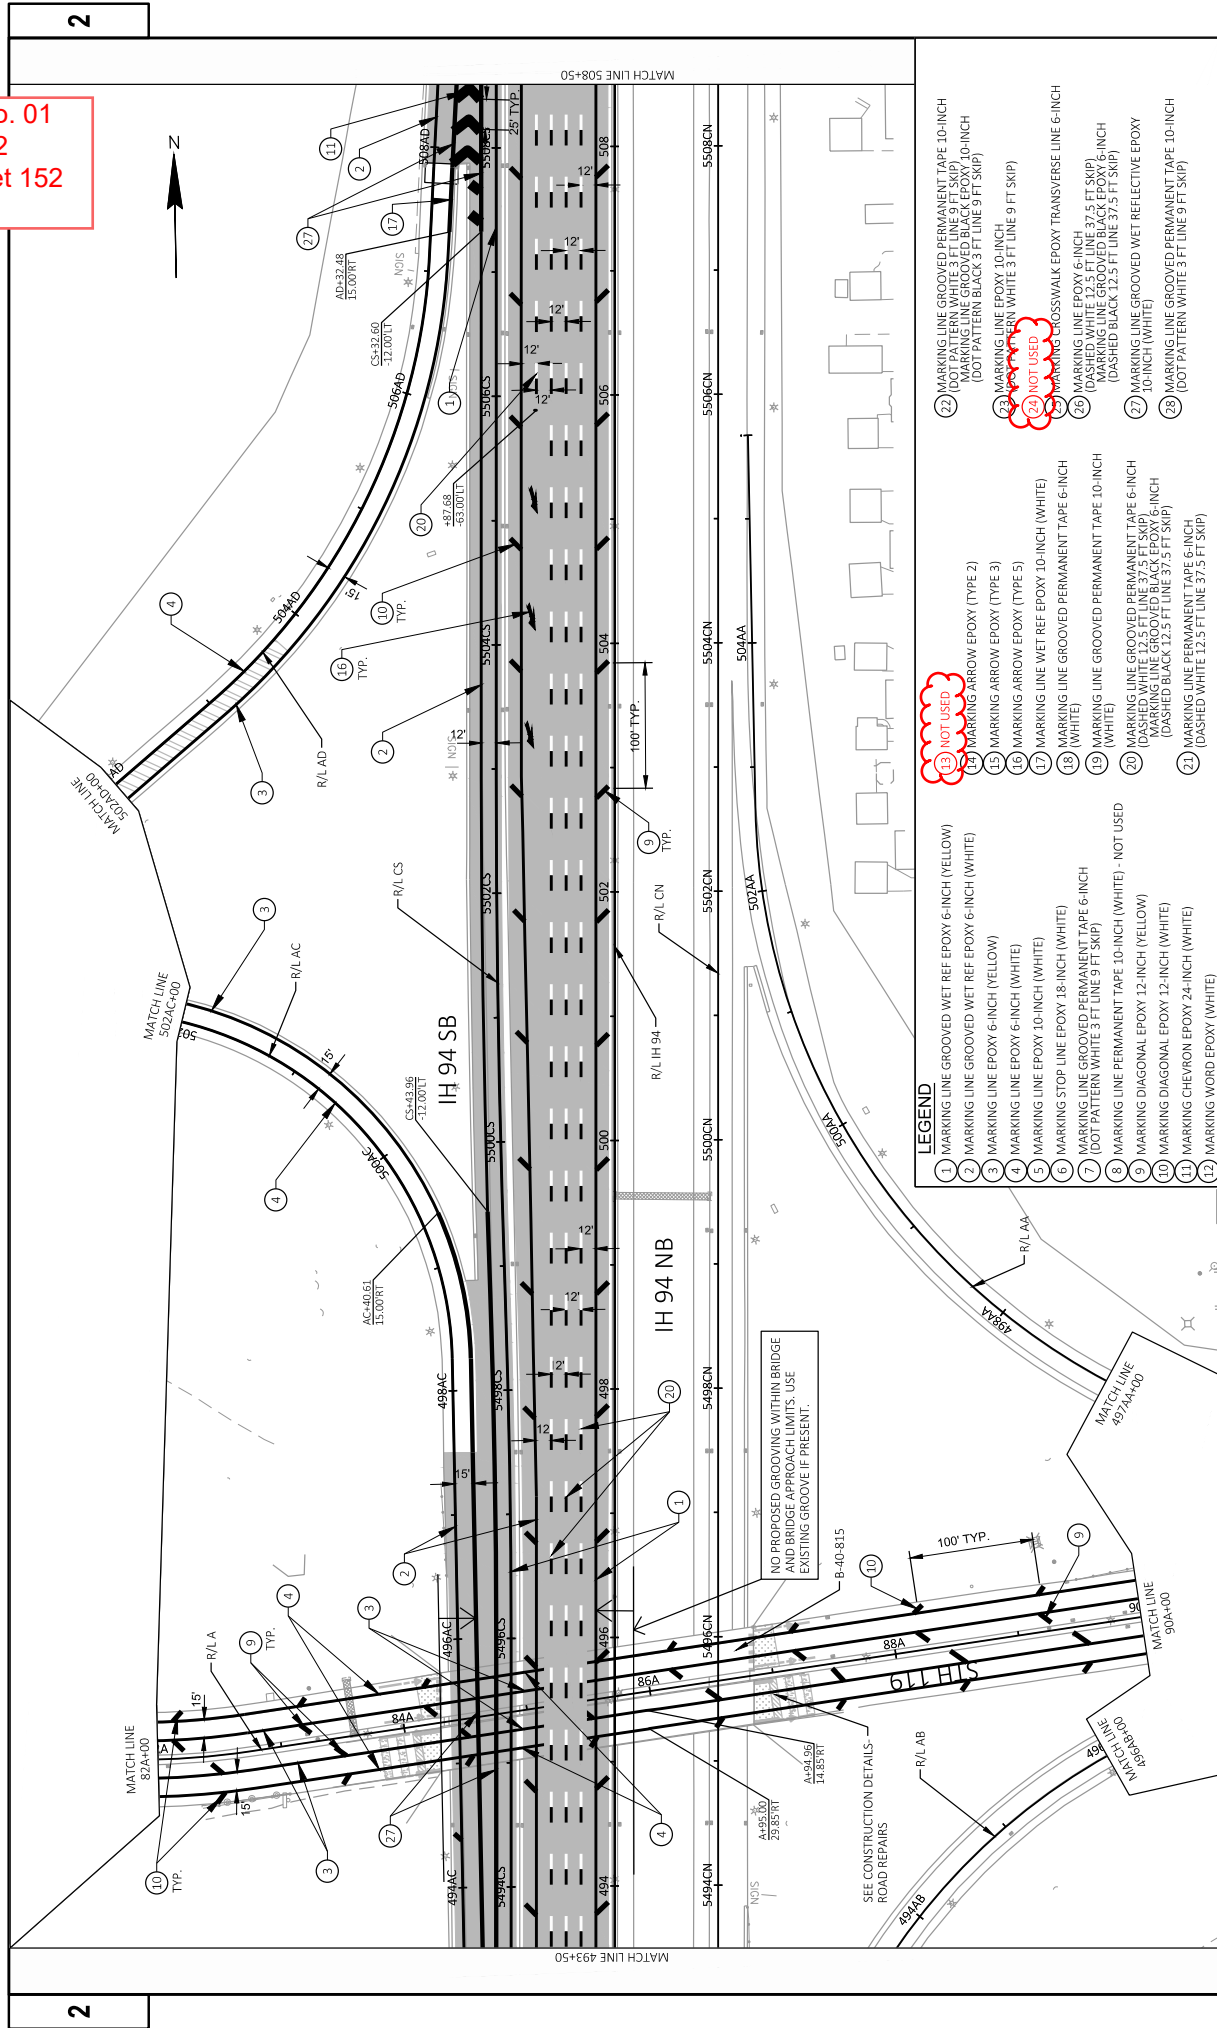

LEGEND


- | | | | |
|----|--|----|---|
| 1 | MARKING LINE GROOVED WET REF EPOXY 6-INCH (YELLOW) | 22 | MARKING LINE GROOVED PERMANENT TAPE 10-INCH (DOT PATTERN WHITE 3 FT LINE 9 FT SKIP) |
| 2 | MARKING LINE GROOVED WET REF EPOXY 6-INCH (WHITE) | 23 | MARKING LINE EPOXY 10-INCH (DOT PATTERN BLACK 3 FT LINE 9 FT SKIP) |
| 3 | MARKING LINE EPOXY 6-INCH (YELLOW) | 24 | MARKING LINE EPOXY 10-INCH (DOT PATTERN WHITE 3 FT LINE 9 FT SKIP) |
| 4 | MARKING LINE EPOXY 6-INCH (WHITE) | 25 | MARKING LINE EPOXY 6-INCH (DASHED WHITE 12.5 FT LINE 37.5 FT SKIP) |
| 5 | MARKING LINE EPOXY 10-INCH (WHITE) | 26 | MARKING LINE GROOVED BLACK EPOXY 6-INCH (DASHED BLACK 12.5 FT LINE 37.5 FT SKIP) |
| 6 | MARKING STOP LINE EPOXY 18-INCH (WHITE) | 27 | MARKING LINE GROOVED WET REFLECTIVE EPOXY 10-INCH (WHITE) |
| 7 | MARKING LINE GROOVED PERMANENT TAPE 6-INCH (DOT PATTERN WHITE 3 FT LINE 9 FT SKIP) | 28 | MARKING LINE GROOVED PERMANENT TAPE 10-INCH (DOT PATTERN WHITE 3 FT LINE 9 FT SKIP) |
| 8 | MARKING LINE PERMANENT TAPE 10-INCH (WHITE) - NOT USED | | |
| 9 | MARKING DIAGONAL EPOXY 12-INCH (YELLOW) | | |
| 10 | MARKING DIAGONAL EPOXY 12-INCH (WHITE) | | |
| 11 | MARKING CHEVRON EPOXY 24-INCH (WHITE) | | |
| 12 | MARKING WORD EPOXY (WHITE) | | |

Addendum No. 01
ID 1030-43-72
Revised Sheet 153
July 2, 2025

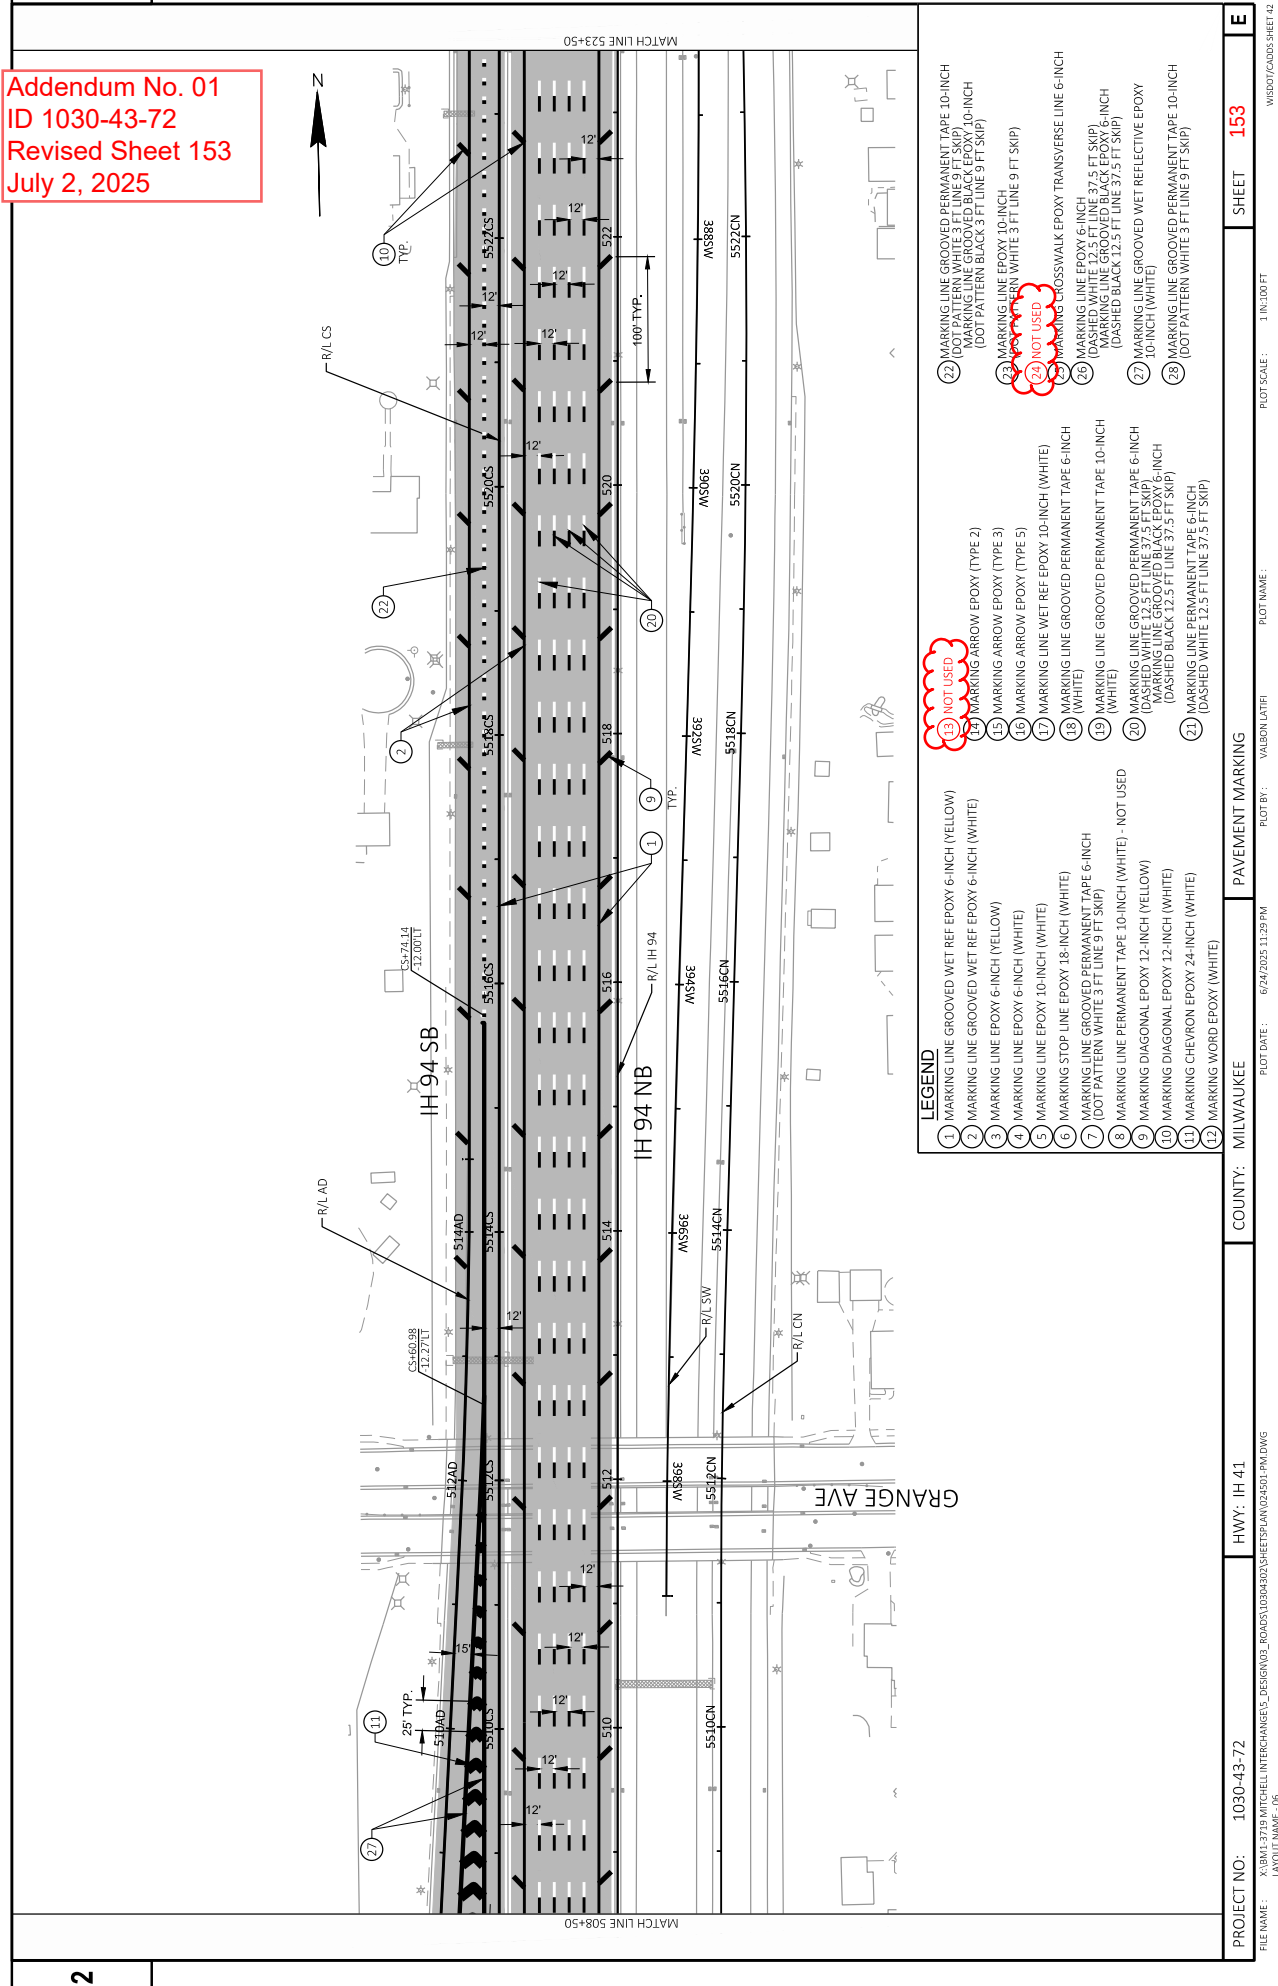



Addendum No. 01
ID 1030-43-72
Revised Sheet 155
July 2, 2025

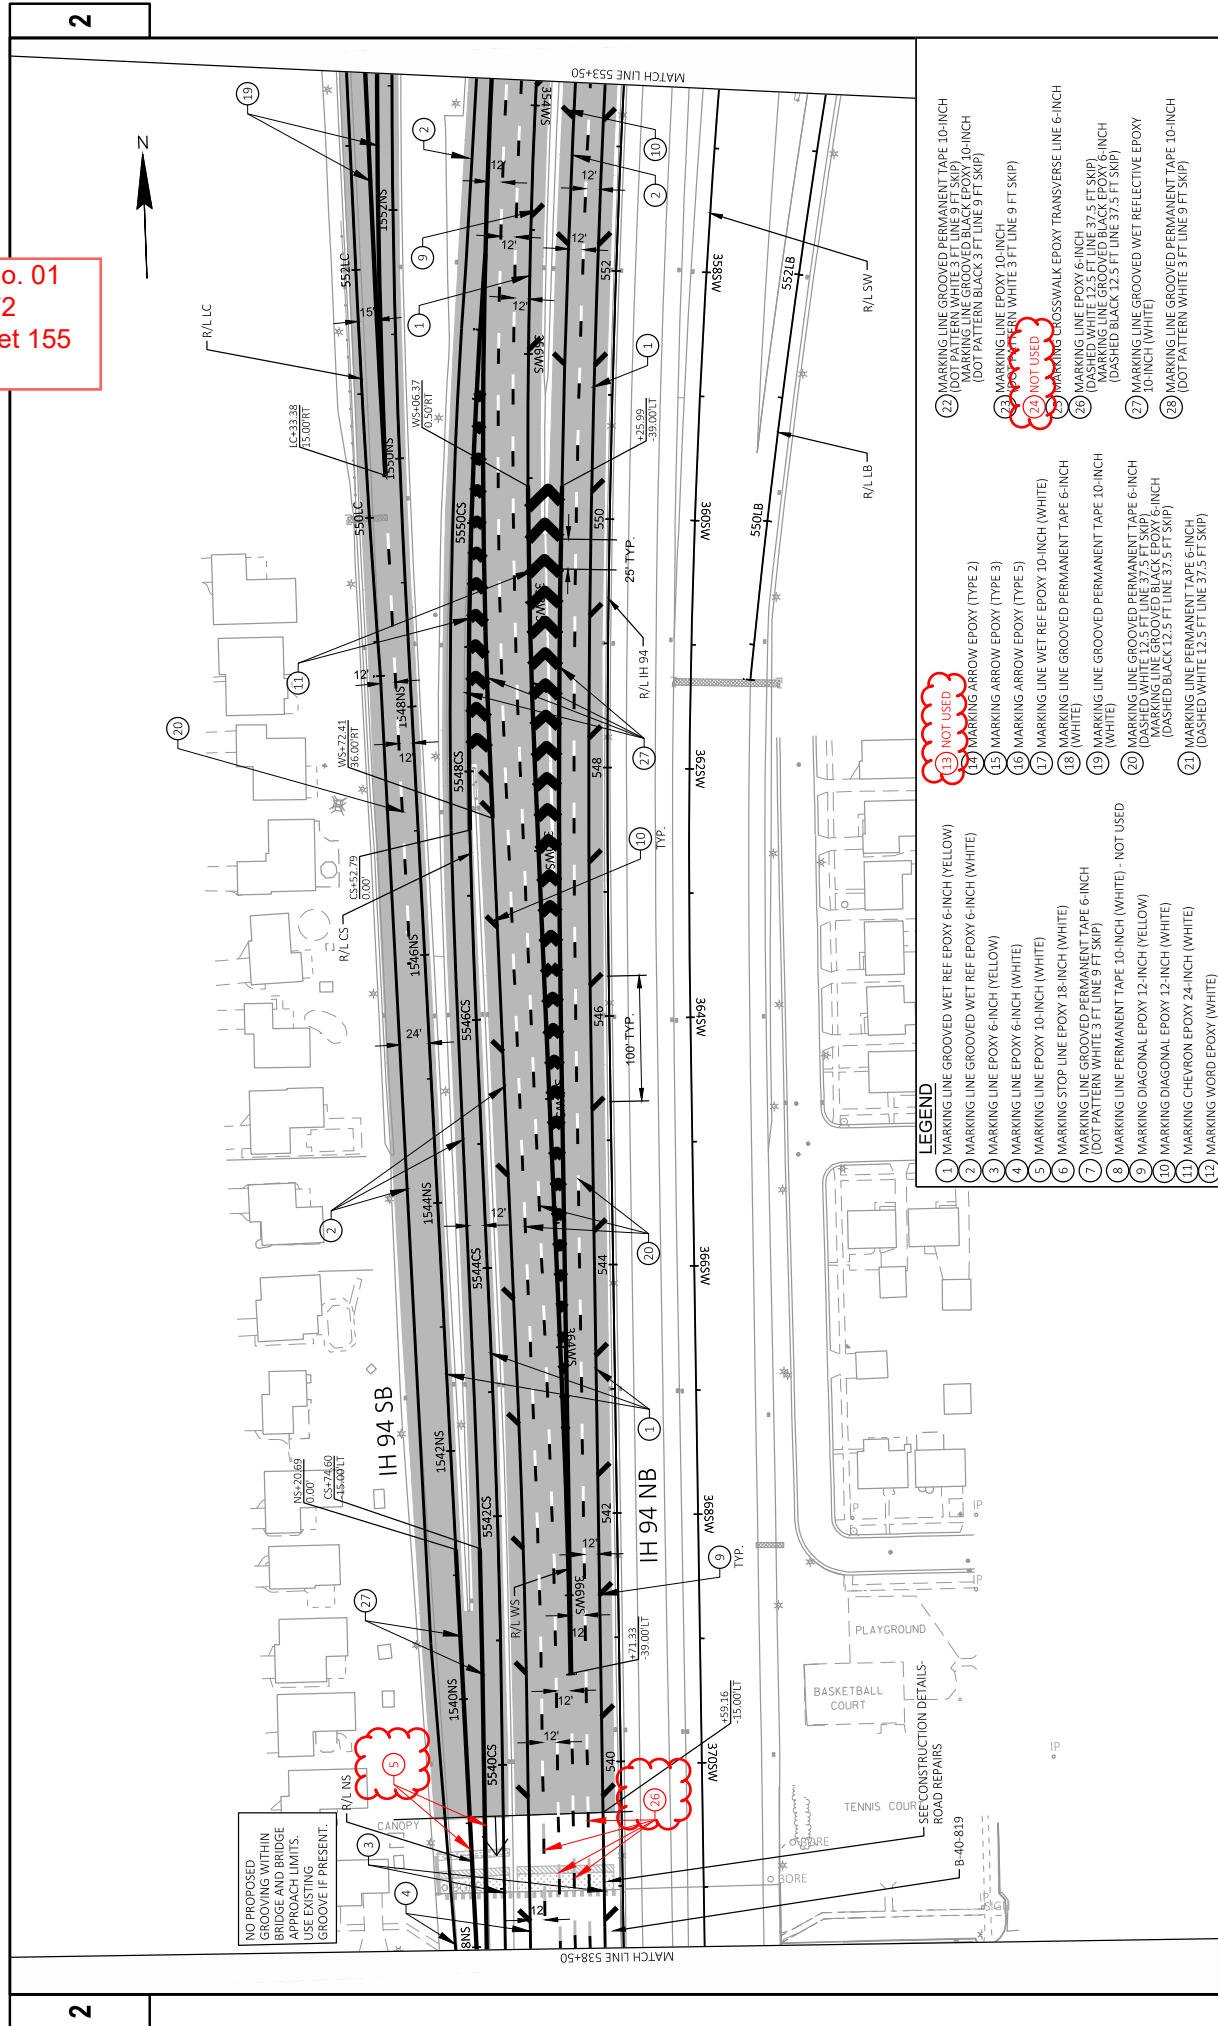


PLOT NAME:	X:\BM\1-2768\MITCHELL_INTERCHANGE_5_DESIGN\RDWIS_RDMAS\1030-43-72\SHEETS\PLAN\02A501.PML.DWG
PLOT DATE:	6/29/2025 11:29 PM
PLOT BY:	VABRON LATIF
PLOT NAME:	E
SHEET SCALE:	1 IN=100 FT
PLOT NO.	PROJECT NO.: 1030-43-72
COUNTY:	MILWAUKEE
Hwy:	IH 41
PAVEMENT MARKING:	
SHEET	155

[illegible]

LEGEND	
1	MARKING LINE GROOVED WET REF EPOXY 6-INCH (YELLOW)
2	MARKING LINE GROOVED WET REF EPOXY 6-INCH (WHITE)
4	MARKING LINE EPOXY 6-INCH (WHITE)
5	MARKING LINE EPOXY 10-INCH (WHITE)
6	MARKING STOP LINE EPOXY 18-INCH (WHITE)
7	MARKING LINE GROOVED PERMANENT TAPE 6-INCH (DOT PATTERN WHITE 3 FT LINE 9 FT SKIP)
8	MARKING LINE PERMANENT TAPE 10-INCH (WHITE) - NOT USED
9	MARKING DIAGONAL EPOXY 12-INCH (YELLOW)
10	MARKING DIAGONAL EPOXY 12-INCH (WHITE)
11	MARKING CHEVRON EPOXY 24-INCH (WHITE)
12	MARKING WORD (WHITE)
13	NOT USED
14	MARKING ARROW EPOXY (TYPE 2)
15	MARKING ARROW EPOXY (TYPE 3)
16	MARKING ARROW EPOXY (TYPE 5)
17	MARKING LINE WET REF EPOXY 10-INCH (WHITE)
18	MARKING LINE GROOVED PERMANENT TAPE 6-INCH (WHITE)
19	MARKING LINE GROOVED PERMANENT TAPE 10-INCH (WHITE)
21	MARKING LINE PERMANENT TAPE 6-INCH (DASHED WHITE 12.5 FT LINE 37.5 FT SKIP)
22	MARKING LINE GROOVED PERMANENT TAPE 10-INCH (DOT PATTERN BLACK 3 FT LINE 9 FT SKIP)
23	MARKING LINE EPOXY 10-INCH (DOT PATTERN WHITE 3 FT LINE 9 FT SKIP)
24	NOT USED
25	MARKING CROSSWALK EPOXY TRANSVERSE LINE 6-INCH (DASHED WHITE 12.5 FT LINE 37.5 FT SKIP)
26	MARKING LINE GROOVED BLACK EPOXY 6-INCH (DASHED BLACK 12.5 FT LINE 37.5 FT SKIP)
27	MARKING LINE GROOVED WET REFLECTIVE EPOXY 10-INCH (WHITE)
28	MARKING LINE GROOVED PERMANENT TAPE 10-INCH (DOT PATTERN WHITE 3 FT LINE 9 FT SKIP)

Addendum No. 01
ID 1030-43-72
Revised Sheet 157
July 2, 2025

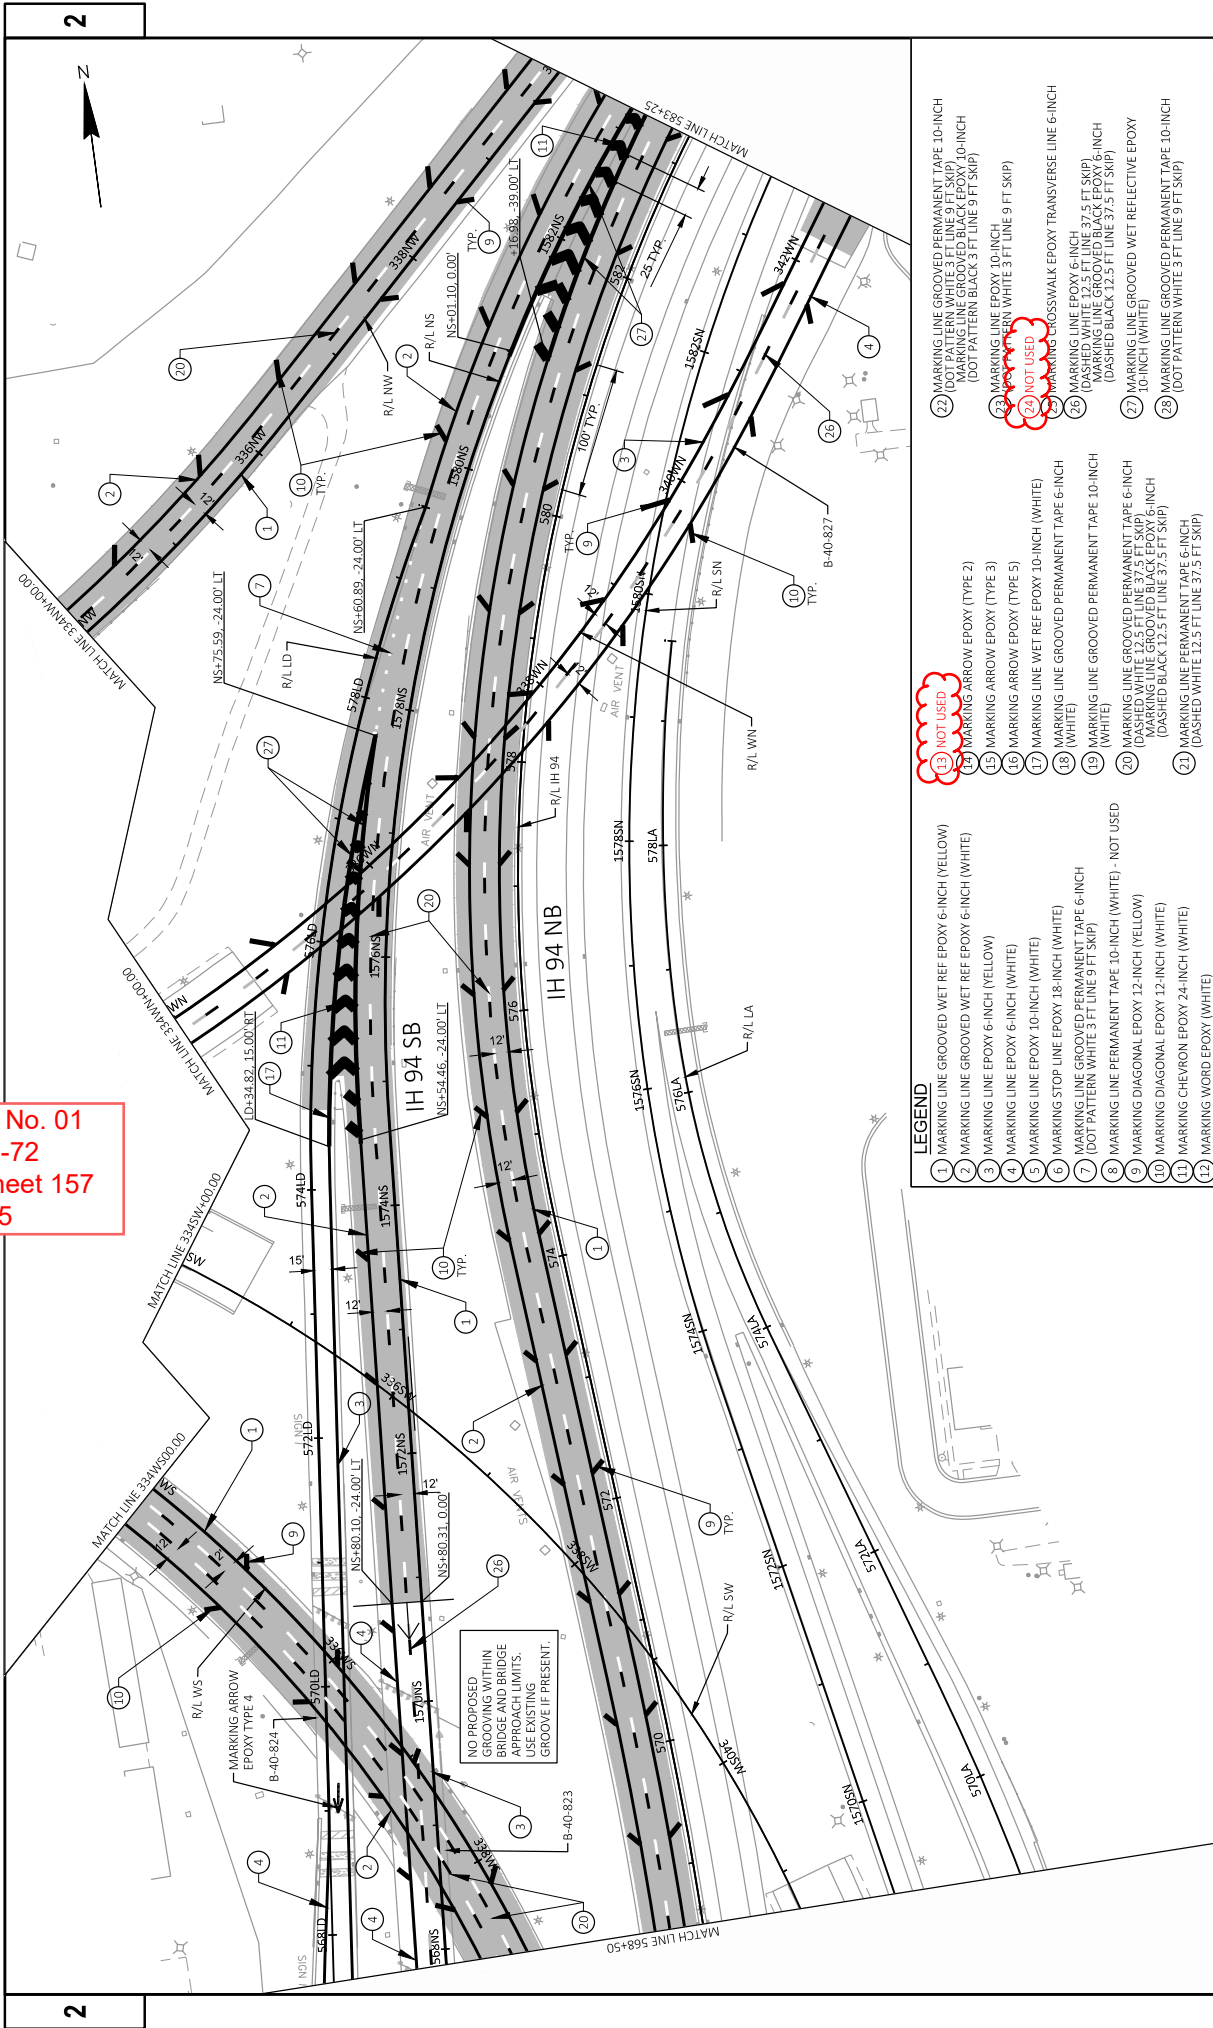


LEGEND


- | | | |
|--|--|--|
| 1 MARKING LINE GROOVED WET REF EPOXY 6-INCH (YELLOW) | 13 NOT USED | 22 MARKING LINE GROOVED PERMANENT TAPE 10-INCH (DOT PATTERN WHITE 3 FT LINE 9 FT SKIP) |
| 2 MARKING LINE GROOVED WET REF EPOXY 6-INCH (WHITE) | 14 MARKING ARROW EPOXY (TYPE 2) | 23 MARKING LINE EPOXY 10-INCH (DOT PATTERN WHITE 3 FT LINE 9 FT SKIP) |
| 3 MARKING LINE EPOXY 6-INCH (YELLOW) | 15 MARKING ARROW EPOXY (TYPE 3) | 24 NOT USED |
| 4 MARKING LINE EPOXY 6-INCH (WHITE) | 16 MARKING ARROW EPOXY (TYPE 5) | 25 MARKING CROSSWALK EPOXY TRANSVERSE LINE 6-INCH (DASHED WHITE 12.5 FT LINE 37.5 FT SKIP) |
| 5 MARKING LINE EPOXY 10-INCH (WHITE) | 17 MARKING LINE WET REF EPOXY 10-INCH (WHITE) | 26 MARKING LINE EPOXY 6-INCH (DASHED WHITE 12.5 FT LINE 37.5 FT SKIP) |
| 6 MARKING STOP LINE EPOXY 18-INCH (WHITE) | 18 MARKING LINE GROOVED PERMANENT TAPE 6-INCH (WHITE) | 27 MARKING LINE GROOVED WET REFLECTIVE EPOXY 10-INCH (WHITE) |
| 7 MARKING LINE GROOVED PERMANENT TAPE 6-INCH (DOT PATTERN WHITE 3 FT LINE 9 FT SKIP) | 19 MARKING LINE GROOVED PERMANENT TAPE 10-INCH (WHITE) | 28 MARKING LINE GROOVED PERMANENT TAPE 10-INCH (DOT PATTERN WHITE 3 FT LINE 9 FT SKIP) |
| 8 MARKING LINE PERMANENT TAPE 10-INCH (WHITE) - NOT USED | 20 MARKING LINE GROOVED PERMANENT TAPE 6-INCH (DASHED WHITE 12.5 FT LINE 37.5 FT SKIP) | |
| 9 MARKING DIAGONAL EPOXY 12-INCH (YELLOW) | 21 MARKING LINE GROOVED BLACK EPOXY 6-INCH (DASHED BLACK 12.5 FT LINE 37.5 FT SKIP) | |
| 10 MARKING DIAGONAL EPOXY 12-INCH (WHITE) | | |
| 11 MARKING CHEVRON EPOXY 24-INCH (WHITE) | | |
| 12 MARKING WORD EPOXY (WHITE) | | |

LEGEND

- [illegible]

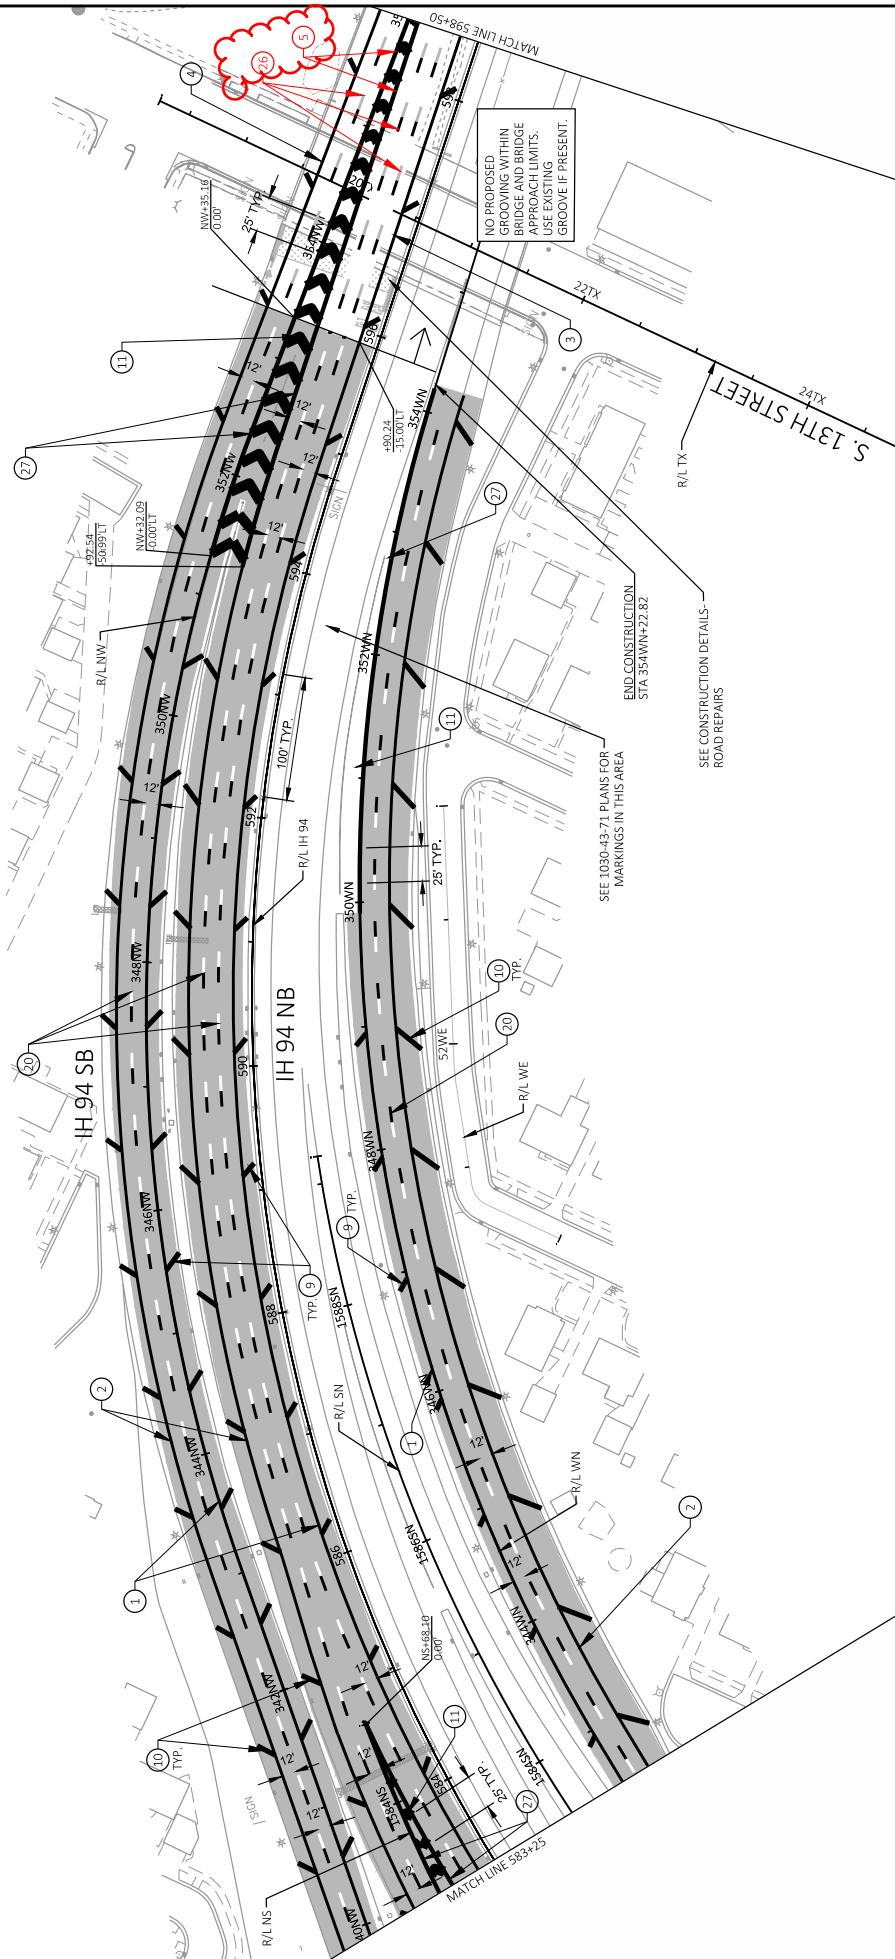


1000

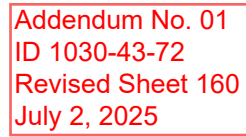


LEGEND	
1.	MARKING LINE GROOVED WET REF EPOXY 6-INCH (YELLOW)
2.	MARKING LINE GROOVED WET REF EPOXY 6-INCH (WHITE)
26.	MARKING LINE EPOXY 6-INCH (DASHED WHITE 12.5 FT LINE 37.5 FT SKIP)
27.	MARKING LINE GROOVED WET REFLECTIVE EPOXY 10-INCH (WHITE)
28.	MARKING LINE GROOVED PERMANENT TAPE 10-INCH (DOT PATTERN WHITE 3 FT LINE 9 FT SKIP)

PROJECT NO:	1030-43-72	HWY:	IH 41	COUNTY:	MILLWAUKEE	PAVEMENT MARKING		SHEET	160	E
FILE NAME:	X:\BM\1-2718\INTERL\INTERCHANGE_5_RESIGN\03_ROADS\10304372\SHEETS\LAW\024501.PWG									
PLOT DATE:	6/24/2025 11:29 PM		PLOT BY:	VALBON LATIFI		PLOT NAME:	J IN JUDT			
WSDOT/CADDIS SHEET 42										

LEGEND	
6	MARKING STOP LINE EPOXY 18-INCH (WHITE)
7	MARKING LINE GROOVED PERMANENT TAPE 6-INCH (DOTTED PATTERN WHITE 3 FT LINE 9 FT SKIP)
8	MARKING LINE PERMANENT TAPE 10-INCH (WHITE) - NOT USED
9	MARKING DIAGONAL EPOXY 12-INCH (YELLOW)
10	MARKING DIAGONAL EPOXY 12-INCH (WHITE)
11	MARKING CHEVRON EPOXY 24-INCH (WHITE)
13	NOT USED
14	MARKING ARROW EPOXY (TYPE 2)
15	MARKING ARROW EPOXY (TYPE 3)
16	MARKING ARROW EPOXY (TYPE 5)
17	MARKING LINE WET REF EPOXY 10-INCH (WHITE)
18	MARKING LINE GROOVED PERMANENT TAPE 6-INCH (WHITE)
19	MARKING LINE GROOVED PERMANENT TAPE 10-INCH (WHITE)
27	MARKING LINE GROOVED WET REFLECTIVE EPOXY 10-INCH (WHITE)
28	MARKING LINE GROOVED PERMANENT TAPE 10-INCH (DOTTED PATTERN WHITE 3 FT LINE 9 FT SKIP)

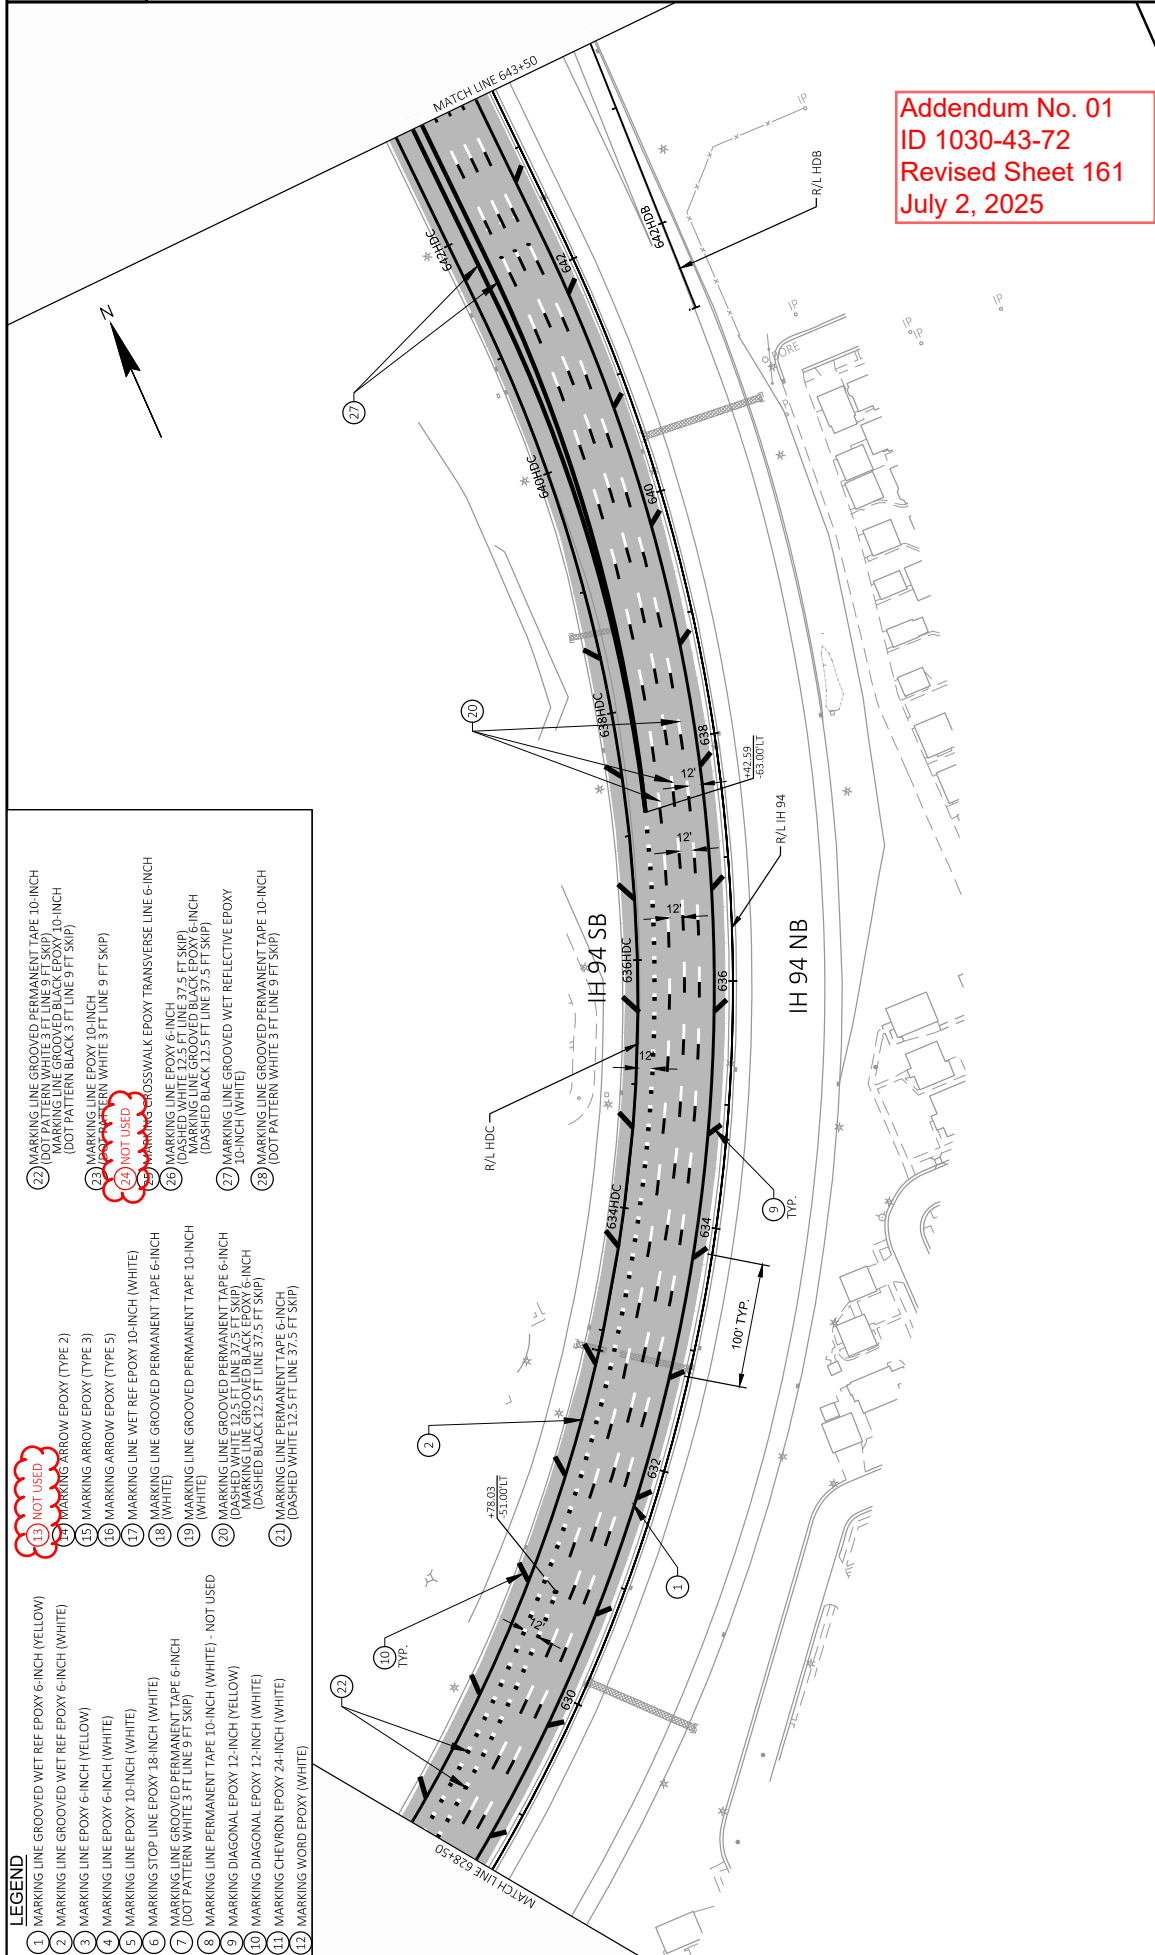


Addendum No. 01
ID 1030-43-72
Revised Sheet 161
July 2, 2025

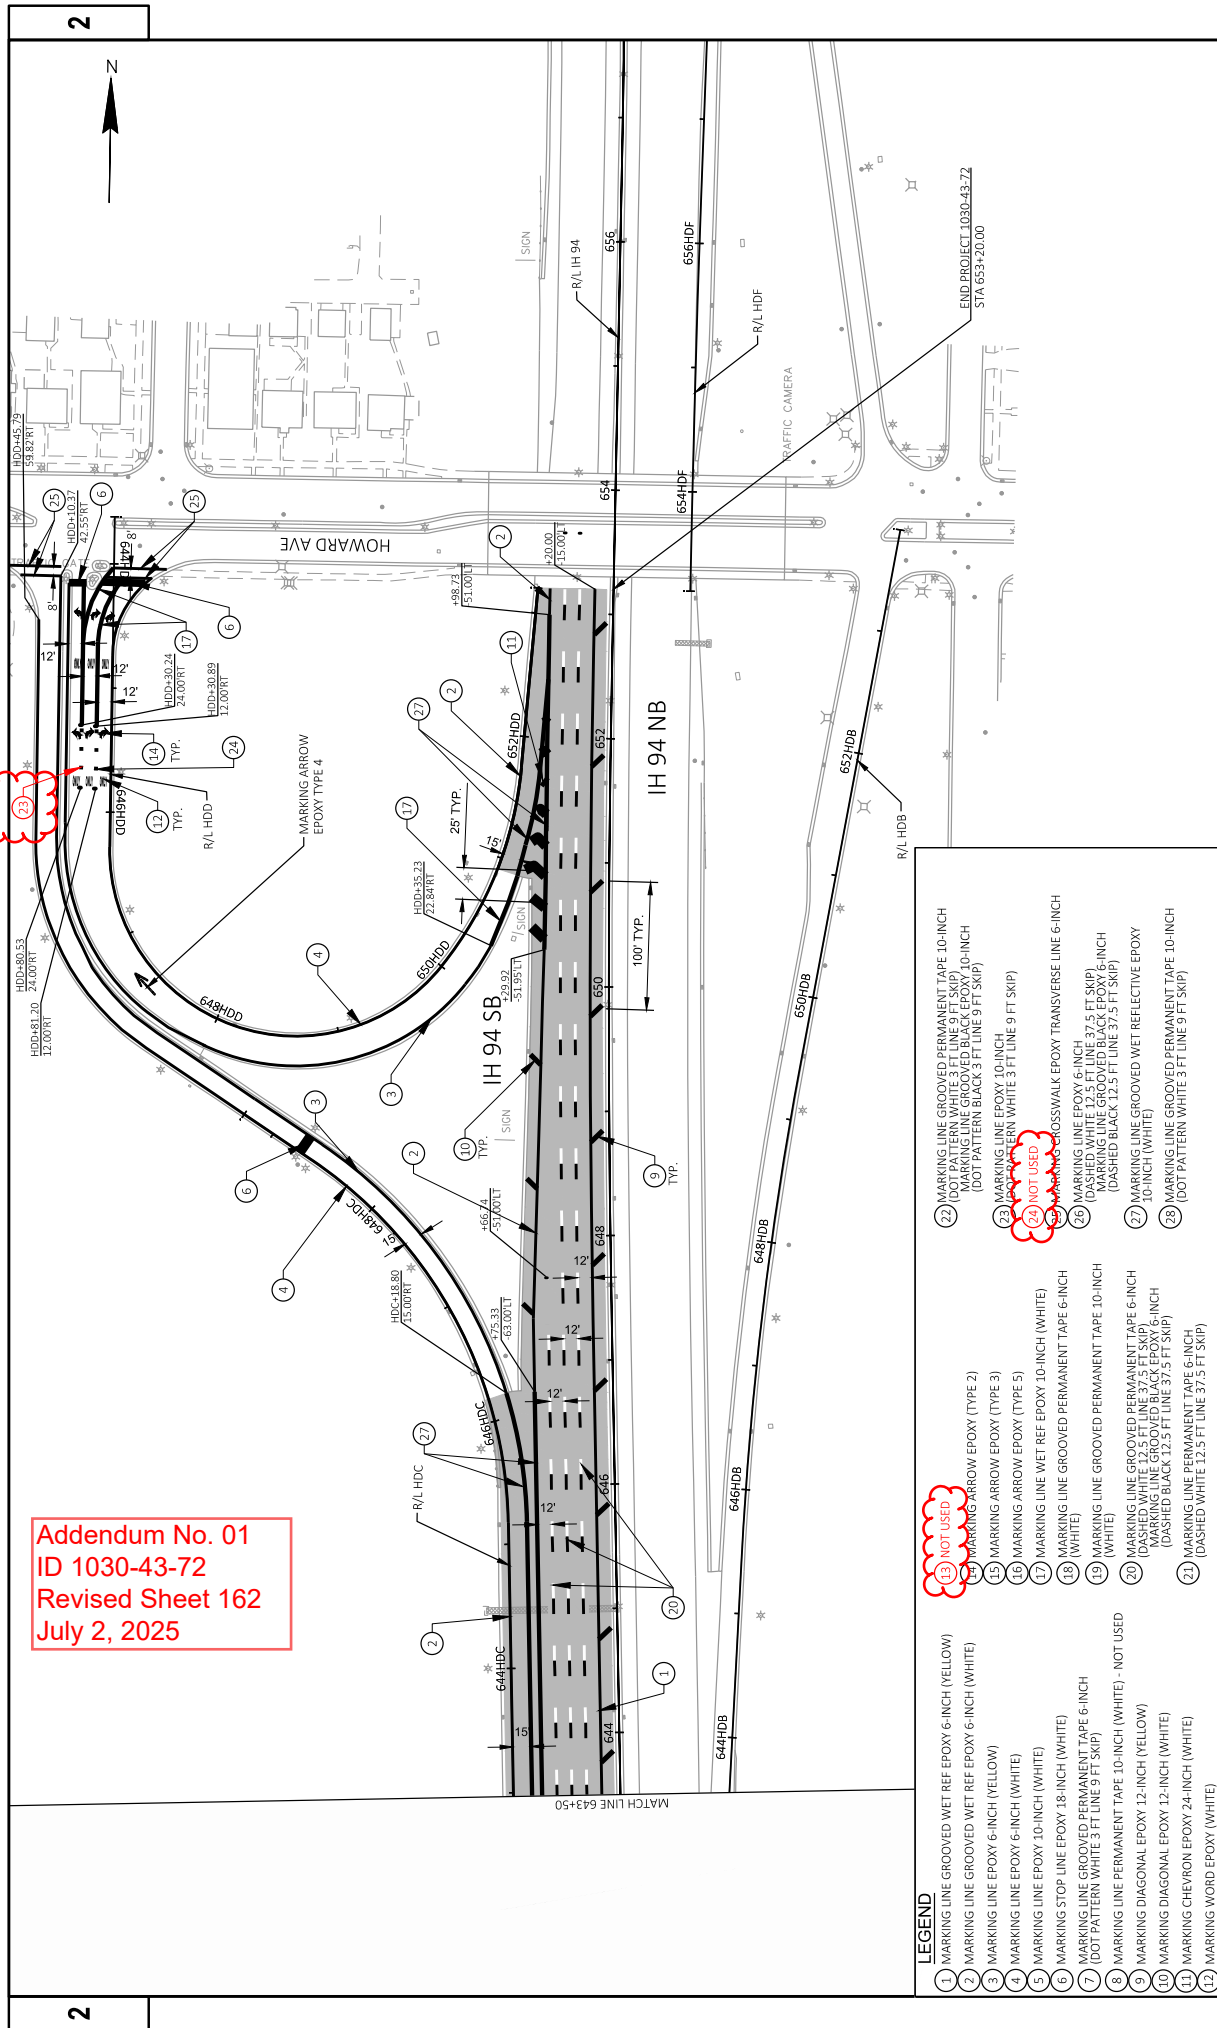

Addendum No. 01
ID 1030-43-72
Revised Sheet 162
July 2, 2025

LEGEND


- 1 MARKING LINE GROOVED WET REF EPOXY 6-INCH (YELLOW)
- 2 MARKING LINE GROOVED WET REF EPOXY 6-INCH (WHITE)
- 3 MARKING LINE EPOXY 6-INCH (YELLOW)
- 4 MARKING LINE EPOXY 6-INCH (WHITE)
- 8 MARKING LINE PERMANENT TAPE 10-INCH (WHITE) - NOT USED
- 9 MARKING DIAGONAL EPOXY 12-INCH (YELLOW)
- 10 MARKING DIAGONAL EPOXY 12-INCH (WHITE)
- 11 MARKING CHEVRON EPOXY 24-INCH (WHITE)
- 12 MARKING WORD EPOXY (WHITE)
- 13 ~~NOT USED~~
- 14 MARKING ARROW EPOXY (TYPE 2)
- 15 MARKING ARROW EPOXY (TYPE 3)
- 16 MARKING ARROW EPOXY (TYPE 5)
- 17 MARKING LINE WET REF EPOXY 10-INCH (WHITE)
- 18 MARKING LINE GROOVED PERMANENT TAPE 6-INCH (WHITE)
- 19 MARKING LINE GROOVED PERMANENT TAPE 10-INCH (WHITE)
- 20 MARKING LINE GROOVED PERMANENT TAPE 6-INCH (MARKING LINE GROOVED BLACK EPOXY 6-INCH (DASHED BLACK 12.5 FT LINE 37.5 FT SKIP))
- 21 MARKING LINE PERMANENT TAPE 6-INCH (DASHED WHITE 12.5 FT LINE 37.5 FT SKIP)
- 22 MARKING LINE GROOVED PERMANENT TAPE 10-INCH (DOT PATTERN WHITE 3 FT LINE 9 FT SKIP)
- 23 MARKING LINE EPOXY 10-INCH (DOT PATTERN WHITE 3 FT LINE 9 FT SKIP)
- 24 ~~NOT USED~~
- 25 MARKING LINE CROSSWALK EPOXY TRANSVERSE LINE 6-INCH (DASHED WHITE 12.5 FT LINE 37.5 FT SKIP)
- 26 MARKING LINE EPOXY 6-INCH (DASHED WHITE 12.5 FT LINE 37.5 FT SKIP)
- 27 MARKING LINE GROOVED WET REFLECTIVE EPOXY 10-INCH (WHITE)
- 28 MARKING LINE GROOVED PERMANENT TAPE 10-INCH (DOT PATTERN WHITE 3 FT LINE 9 FT SKIP)

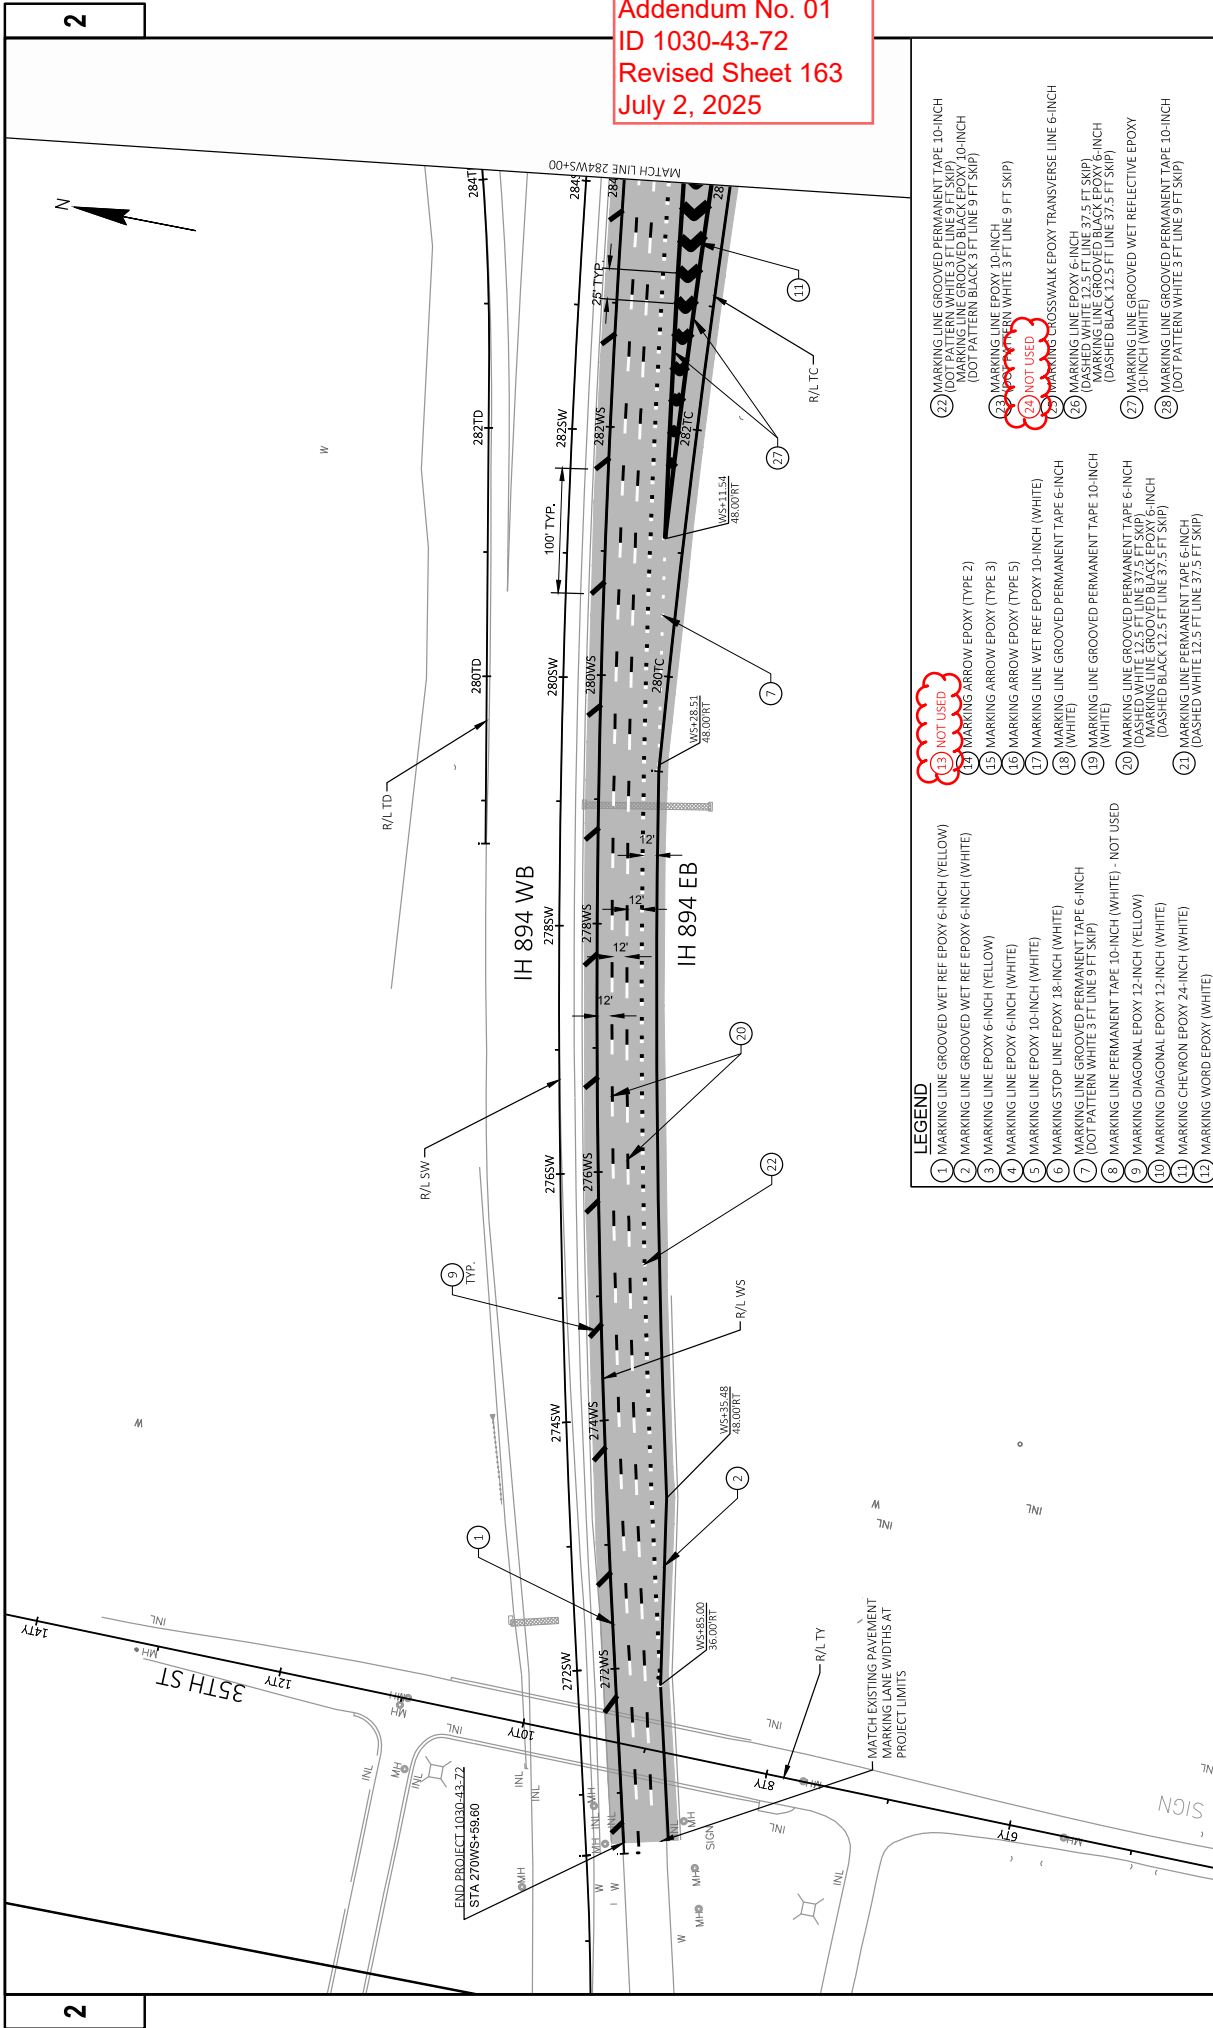

Addendum No. 01
ID 1030-43-72
Revised Sheet 163
July 2, 2025

LEGEND	
1	MARKING LINE GROOVED WET REF EPOXY 6-INCH (YELLOW)
2	MARKING LINE GROOVED WET REF EPOXY 6-INCH (WHITE)
3	MARKING LINE EPOXY 6-INCH (YELLOW)
4	MARKING LINE EPOXY 6-INCH (WHITE)
5	MARKING STOP LINE EPOXY 18-INCH (WHITE)
6	MARKING LINE GROOVED PERMANENT TAPE 6-INCH (DOT PATTERN WHITE 3 FT LINE 9 FT SKIP)
7	MARKING LINE GROOVED PERMANENT TAPE 6-INCH (WHITE)
8	MARKING LINE PERMANENT TAPE 10-INCH (WHITE) - NOT USED
9	MARKING DIAGONAL EPOXY 12-INCH (YELLOW)
10	MARKING DIAGONAL EPOXY 12-INCH (WHITE)
11	MARKING CHEVRON EPOXY 24-INCH (WHITE)
12	MARKING WORD EPOXY (WHITE)
13	NOT USED
14	MARKING ARROW EPOXY (TYPE 2)
15	MARKING ARROW EPOXY (TYPE 3)
16	MARKING ARROW EPOXY (TYPE 5)
17	MARKING LINE WET REF EPOXY 10-INCH (WHITE)
18	MARKING LINE GROOVED PERMANENT TAPE 6-INCH (WHITE)
19	MARKING LINE GROOVED PERMANENT TAPE 10-INCH (WHITE)
20	MARKING LINE GROOVED PERMANENT TAPE 6-INCH (DASHED WHITE 12.5 FT LINE 37.5 FT SKIP)
21	MARKING LINE GROOVED PERMANENT TAPE 10-INCH (DASHED WHITE 12.5 FT LINE 37.5 FT SKIP)
22	MARKING LINE GROOVED PERMANENT TAPE 10-INCH (DOT PATTERN WHITE 3 FT LINE 9 FT SKIP)
23	MARKING LINE EPOXY 10-INCH (DOT PATTERN WHITE 3 FT LINE 9 FT SKIP)
24	NOT USED
25	MARKING CROSSWALK EPOXY TRANSVERSE LINE 6-INCH (DASHED WHITE 12.5 FT LINE 37.5 FT SKIP)
26	MARKING LINE GROOVED BLACK EPOXY 6-INCH (DASHED BLACK 12.5 FT LINE 37.5 FT SKIP)
27	MARKING LINE GROOVED WET REFLECTIVE EPOXY 10-INCH (WHITE)
28	MARKING LINE GROOVED PERMANENT TAPE 10-INCH (DOT PATTERN WHITE 3 FT LINE 9 FT SKIP)

Addendum No. 01
ID 1030-43-72
Revised Sheet 165
July 2, 2025

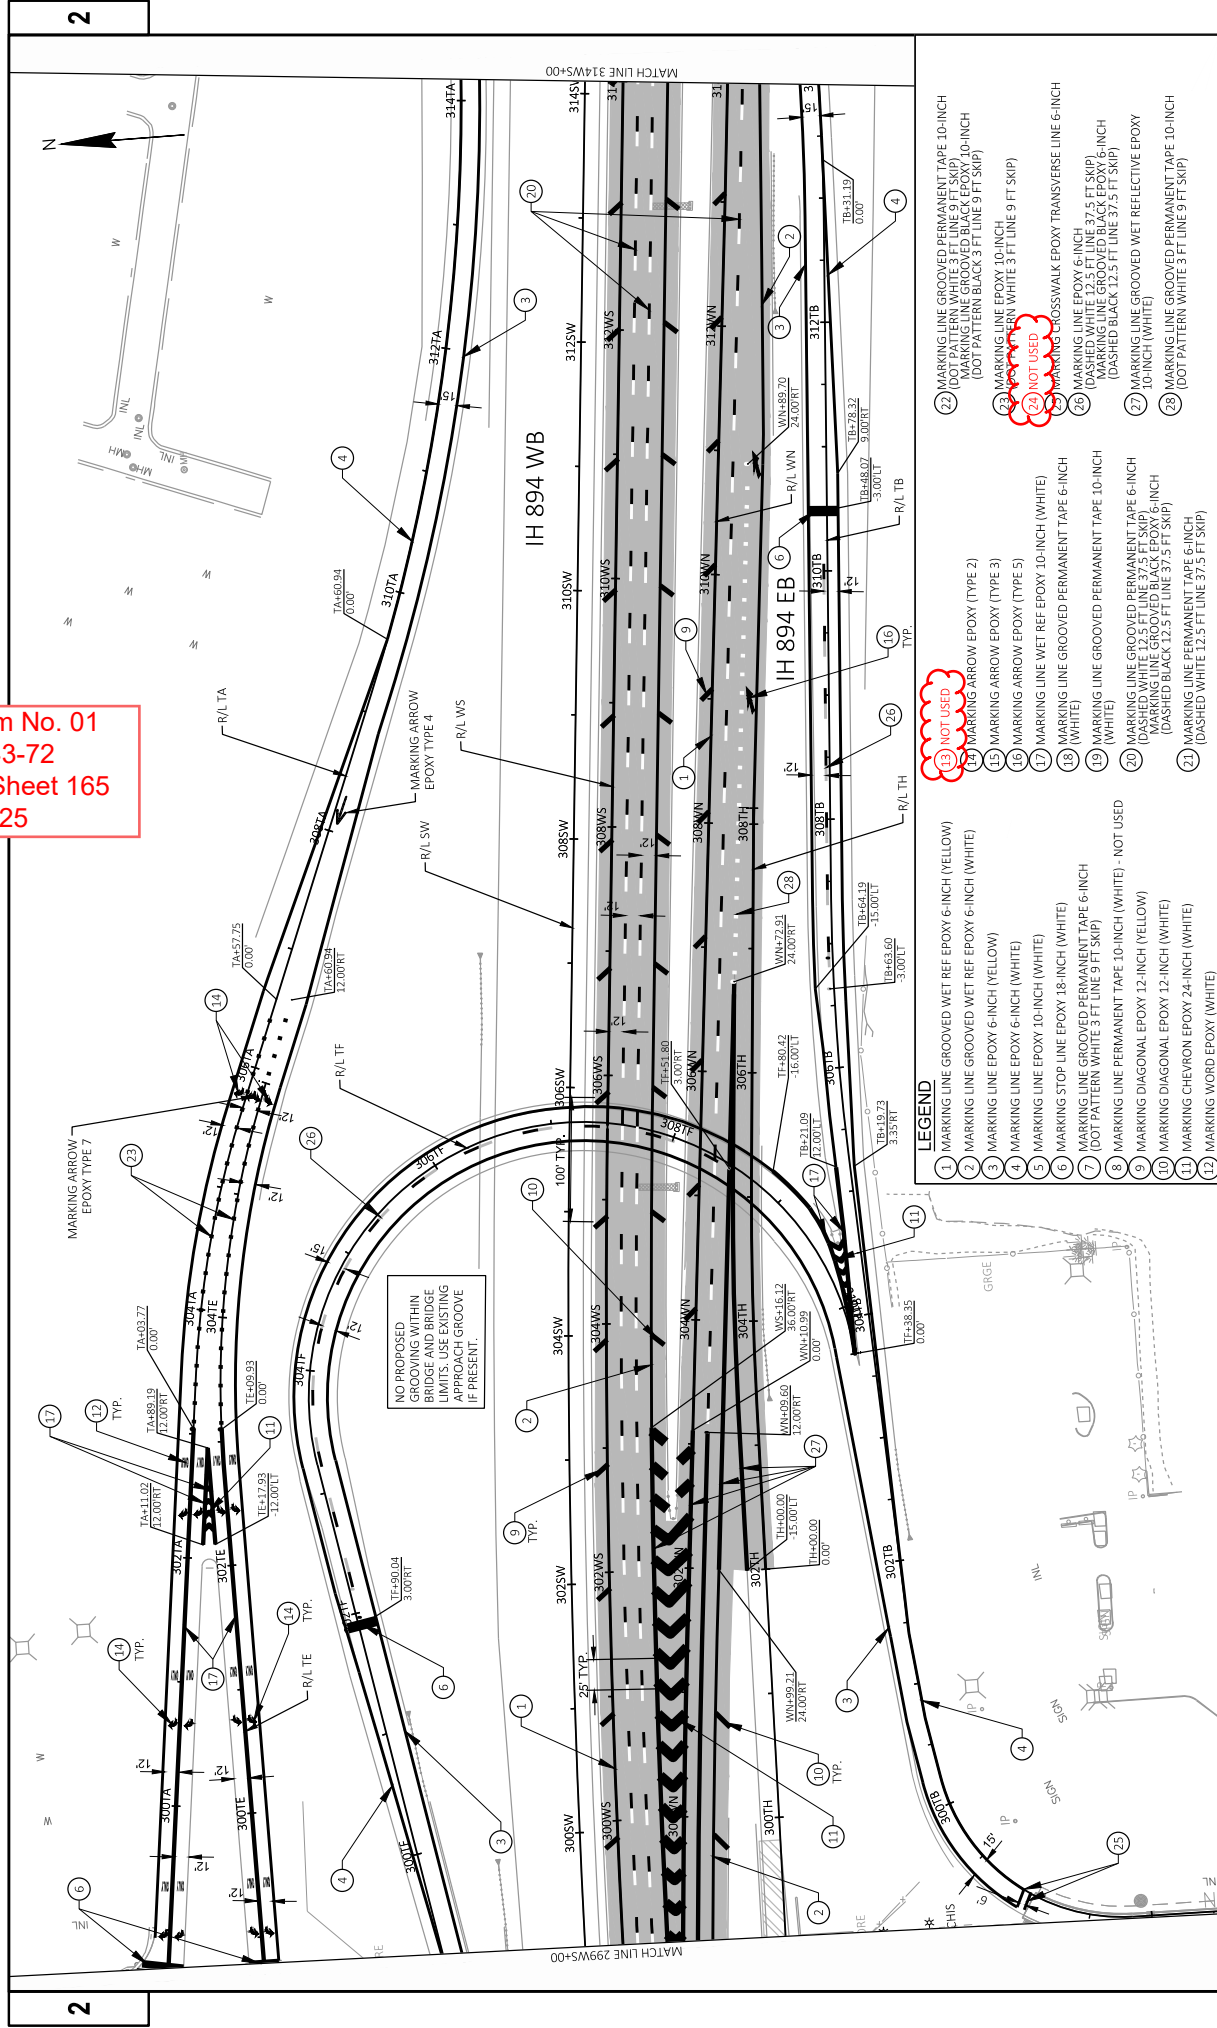

- LEGEND**
- 1 MARKING LINE GROOVED WET REF EPOXY 6-INCH (YELLOW)
 - 2 MARKING LINE GROOVED WET REF EPOXY 6-INCH (WHITE)
 - 3 MARKING LINE EPOXY 6-INCH (YELLOW)
 - 4 MARKING LINE EPOXY 6-INCH (WHITE)
 - 5 MARKING STOP EPOXY 18-INCH (WHITE)
 - 6 MARKING LINE GROOVED PERMANENT TAPE 6-INCH (DOT PATTERN WHITE 3 FT LINE 9 FT SKIP)
 - 7 MARKING LINE GROOVED PERMANENT TAPE 6-INCH (DOT PATTERN WHITE 3 FT LINE 9 FT SKIP)
 - 8 MARKING LINE GROOVED PERMANENT TAPE 10-INCH (WHITE) - NOT USED
 - 9 MARKING DIAGONAL EPOXY 12-INCH (YELLOW)
 - 10 MARKING DIAGONAL EPOXY 12-INCH (WHITE)
 - 11 MARKING CHEVRON EPOXY 24-INCH (WHITE)
 - 12 MARKING WORD EPOXY (WHITE)
 - 13 **NOT USED**
 - 14 MARKING ARROW EPOXY (TYPE 2)
 - 15 MARKING ARROW EPOXY (TYPE 3)
 - 16 MARKING ARROW EPOXY (TYPE 5)
 - 17 MARKING LINE WET REF EPOXY 10-INCH (WHITE)
 - 18 MARKING LINE GROOVED PERMANENT TAPE 6-INCH (WHITE)
 - 19 MARKING LINE GROOVED PERMANENT TAPE 10-INCH (WHITE)
 - 20 MARKING LINE GROOVED PERMANENT TAPE 6-INCH (DASHED WHITE 12.5 FT LINE 37.5 FT SKIP)
 - 22 MARKING LINE GROOVED PERMANENT TAPE 10-INCH (DOT PATTERN WHITE 3 FT LINE 9 FT SKIP)
 - 23 MARKING LINE EPOXY 10-INCH (DOT PATTERN WHITE 3 FT LINE 9 FT SKIP)
 - 24 **NOT USED**
 - 25 MARKING CROSSWALK EPOXY TRANSVERSE LINE 6-INCH (DASHED WHITE 12.5 FT LINE 37.5 FT SKIP)
 - 26 MARKING LINE GROOVED BLACK EPOXY 6-INCH (DASHED BLACK 12.5 FT LINE 37.5 FT SKIP)
 - 27 MARKING LINE GROOVED WET REFLECTIVE EPOXY 10-INCH (WHITE)
 - 28 MARKING LINE GROOVED PERMANENT TAPE 10-INCH (DOT PATTERN WHITE 3 FT LINE 9 FT SKIP)

SHEET	166	E
-------	-----	---

WISDOT/CADD SHEET 4


PROJECT NO: 1030-43-72


FILE NAME: X:\BM1-3719 MITCHELL INTERCHANG
LAYOUT NAME - 19

FILE NAME : X:\BM1-3719 MITCHELL INTERCHANG
LAYOUT NAME - 19

- 1 MARKING LINE GROOVED WET REF EPOXY 6-INCH (YELLOW)
- 2 MARKING LINE GROOVED WET REF EPOXY 6-INCH (WHITE)
- 3 MARKING LINE EPOXY 6-INCH (YELLOW)
- 4 MARKING LINE EPOXY 6-INCH (WHITE)
- 5 MARKING LINE EPOXY 10-INCH (WHITE)
- 6 MARKING STOP LINE EPOXY 18-INCH (WHITE)
- 7 MARKING LINE GROOVED PERMANENT TAPE 6-INCH (DOT PATTERN WHITE 3 FT LINE 9 FT SKIP)
- 8 MARKING LINE PERMANENT TAPE 10-INCH (WHITE) - NOT USED
- 9 MARKING DIAGONAL EPOXY 12-INCH (YELLOW)
- 10 MARKING DIAGONAL EPOXY 12-INCH (WHITE)
- 11 MARKING CHEVRON EPOXY 24-INCH (WHITE)
- 12 MARKING WORD EPOXY (WHITE)


13. **NOT USED**
14. MARKING ARROW EPOXY (TYPE 2)
15. MARKING ARROW EPOXY (TYPE 3)
16. MARKING ARROW EPOXY (TYPE 5)
17. MARKING LINE WET REF EPOXY 10-INCH (WHITE)
18. MARKING LINE GROOVED PERMANENT TAPE 6-INCH (WHITE)
19. MARKING LINE GROOVED PERMANENT TAPE 10-INCH (WHITE)

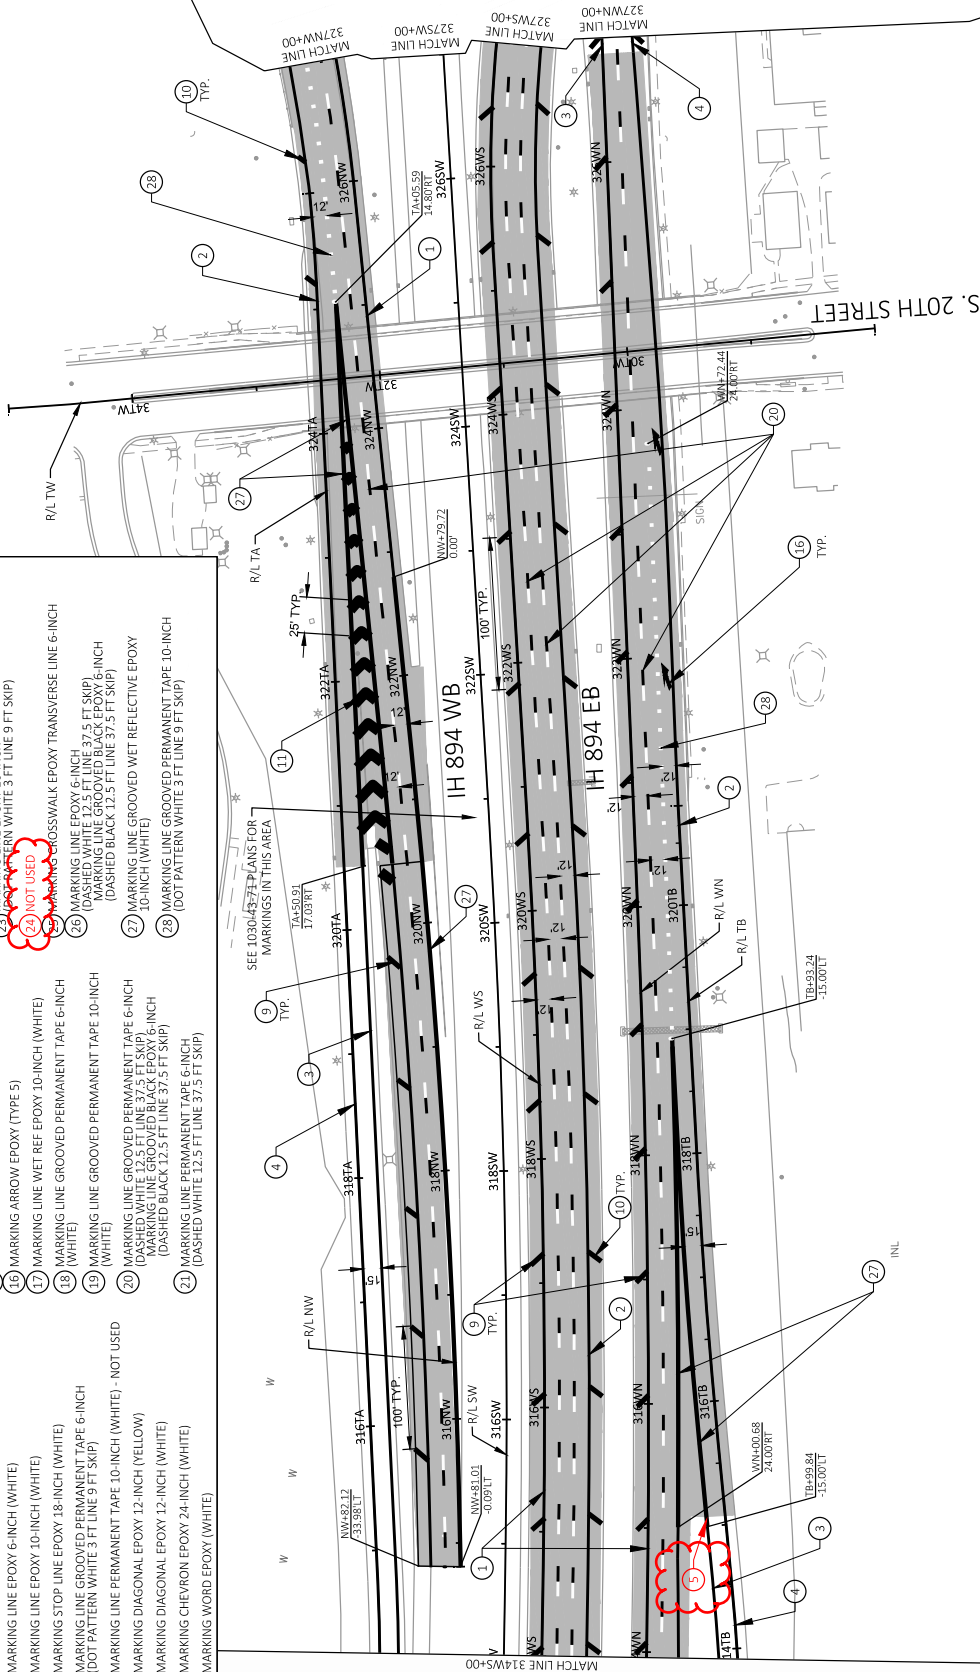

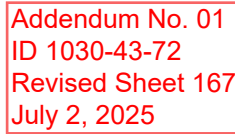

- ## LEGEND


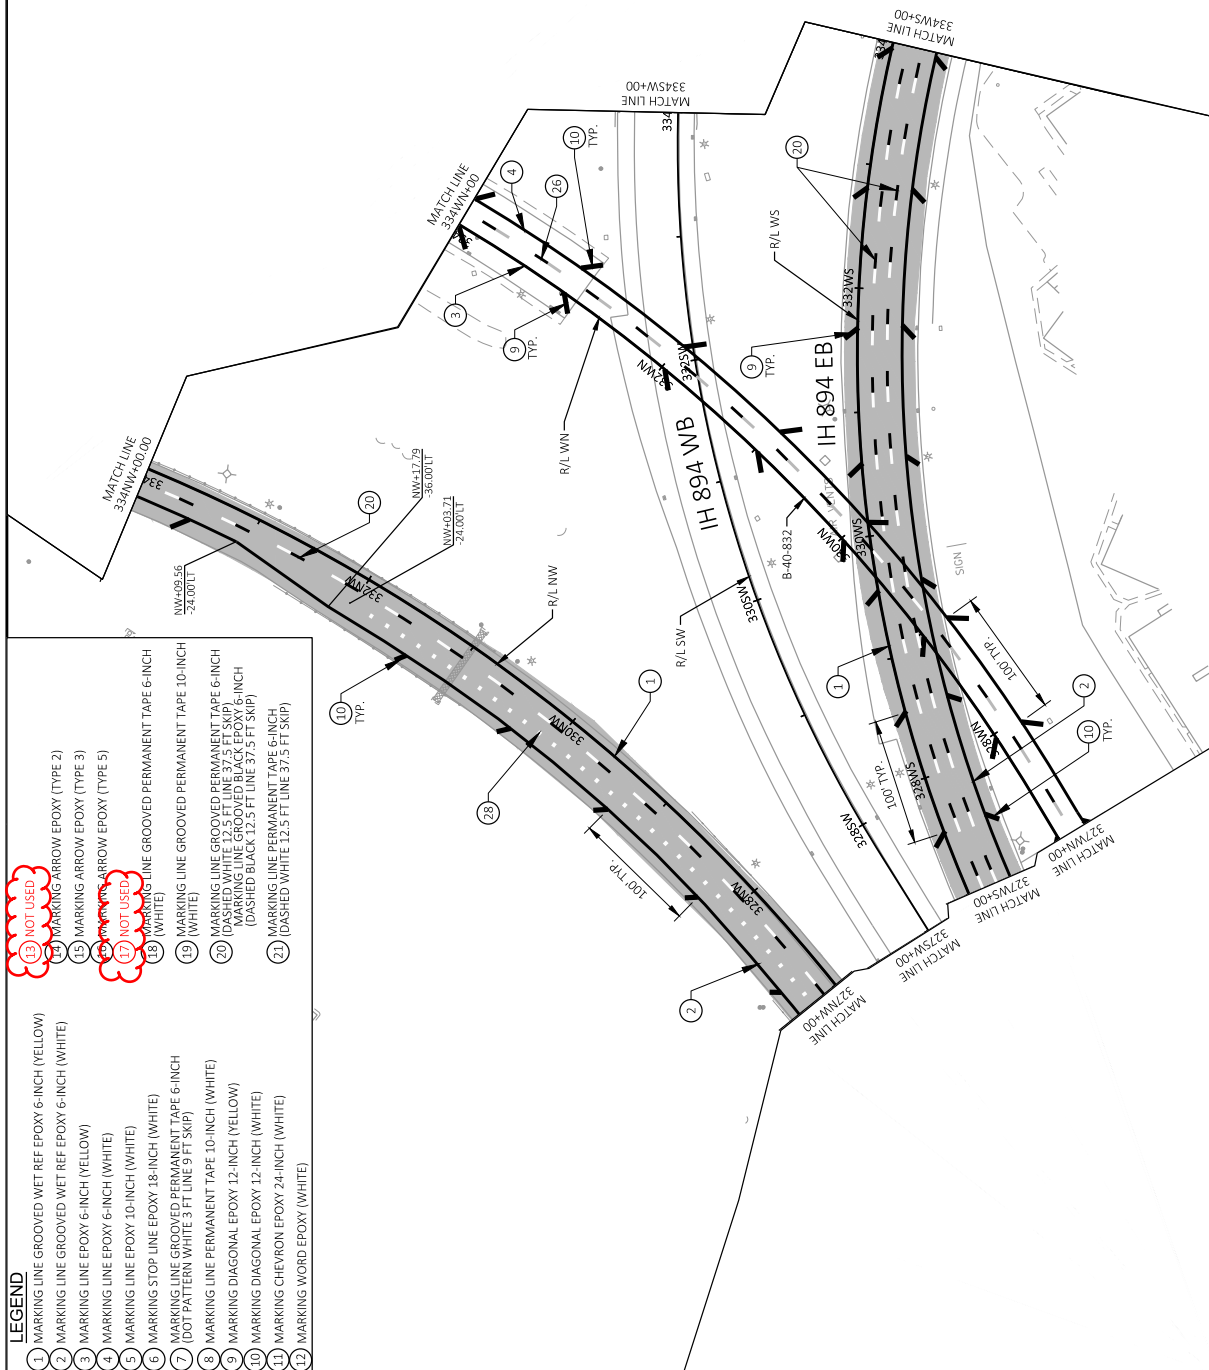


LEGEND

- 1 MARKING LINE GROOVED WET REF EPOXY 6-INCH (YELLOW)
- 2 MARKING LINE GROOVED WET REF EPOXY 6-INCH (WHITE)
- 3 MARKING LINE EPOXY 6-INCH (YELLOW)
- 4 MARKING LINE EPOXY 6-INCH (WHITE)
- 5 MARKING LINE EPOXY 10-INCH (WHITE)
- 6 MARKING STOP LINE EPOXY 18-INCH (WHITE)
- 7 MARKING LINE GROOVED PERMANENT TAPE 6-INCH (DOT PATTERN WHITE 3 FT LINE 9 FT SKIP)
- 8 MARKING LINE PERMANENT TAPE 10-INCH (WHITE) - NOT USED
- 9 MARKING DIAGONAL EPOXY 12-INCH (YELLOW)
- 10 MARKING DIAGONAL EPOXY 12-INCH (WHITE)
- 11 MARKING CHEVRON EPOXY 24-INCH (WHITE)
- 12 MARKING WORD EPOXY (WHITE)
- 13 NOT USED
- 14 MARKING ARROW EPOXY (TYPE 2)
- 15 MARKING ARROW EPOXY (TYPE 3)
- 16 MARKING ARROW EPOXY (TYPE 5)
- 17 MARKING LINE WET REF EPOXY 10-INCH (WHITE)
- 18 MARKING LINE GROOVED PERMANENT TAPE 6-INCH (WHITE)
- 19 MARKING LINE GROOVED PERMANENT TAPE 10-INCH (WHITE)
- 20 MARKING LINE GROOVED PERMANENT TAPE 6-INCH (DASHED WHITE 12.5 FT LINE 37.5 FT SKIP)
- 21 MARKING LINE GROOVED PERMANENT TAPE 10-INCH (DASHED WHITE 12.5 FT LINE 37.5 FT SKIP)
- 22 MARKING LINE GROOVED PERMANENT TAPE 10-INCH (DOT PATTERN WHITE 3 FT LINE 9 FT SKIP)
- 23 MARKING LINE EPOXY 10-INCH (DOT PATTERN WHITE 3 FT LINE 9 FT SKIP)
- 24 NOT USED
- 25 MARKING CROSSWALK EPOXY TRANSVERSE LINE 6-INCH
- 26 MARKING LINE EPOXY 6-INCH (DASHED WHITE 12.5 FT LINE 37.5 FT SKIP)



Addendum No. 01
ID 1030-43-72
Revised Sheet 168
July 2, 2025

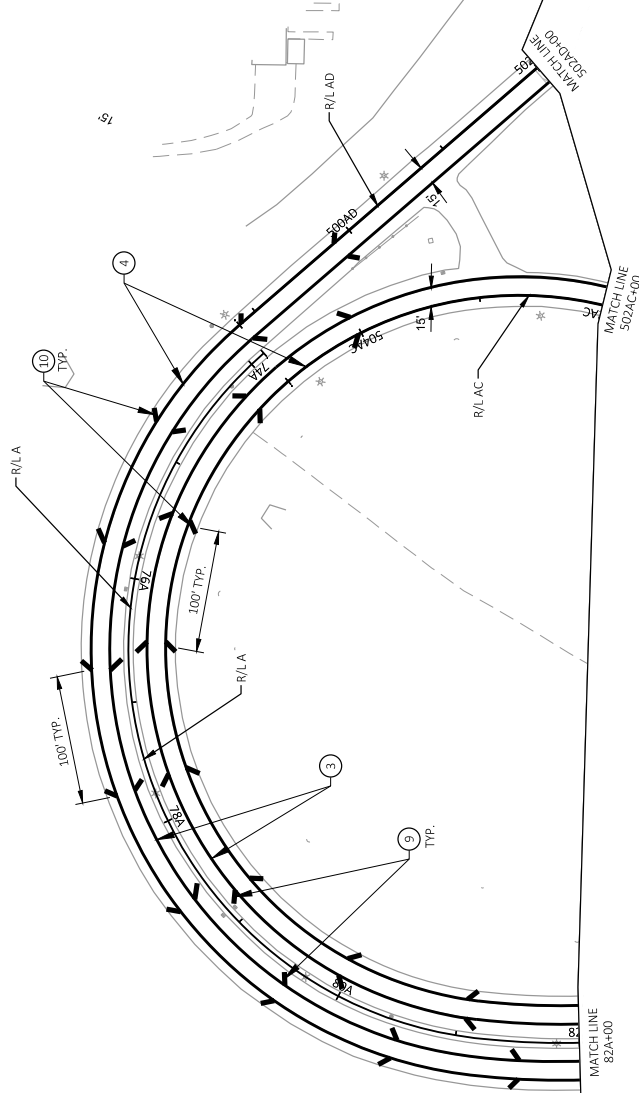

PROJECT NO: 1030-43-72	HWY: IH 41	COUNTY: MILWAUKEE	PAVEMENT MARKING	SHEET 168	E
FILE NAME: X:\BM\13719 MITCHELL INTERCHANGE\DESIGN\03_ROADS\10304302\3SHEETS\PLAN\024301.PLDWG	LAYOUT NAME: 21	6/24/2025 11:30 PM	6/24/2025 11:30 PM	1 IN=100 FT	WISDOT/CADDS SHEET 168

LEGEND


- 1 MARKING LINE GROOVED WET REF EPOXY 6-INCH (YELLOW)
- 2 MARKING LINE GROOVED WET REF EPOXY 6-INCH (WHITE)
- 3 MARKING LINE EPOXY 6-INCH (YELLOW)
- 4 MARKING LINE EPOXY 6-INCH (WHITE)
- 5 MARKING LINE EPOXY 10-INCH (WHITE)
- 6 MARKING STOP LINE EPOXY 18-INCH (WHITE)
- 7 MARKING LINE GROOVED PERMANENT TAPE 6-INCH (DOT PATTERN WHITE 3 FT LINE 9 FT SKIP)
- 8 MARKING LINE PERMANENT TAPE 10-INCH (WHITE) - NOT USED
- 9 MARKING DIAGONAL EPOXY 12-INCH (YELLOW)
- 10 MARKING DIAGONAL EPOXY 12-INCH (WHITE)
- 11 MARKING CHEVRON EPOXY 24-INCH (WHITE)
- 12 MARKING WORD EPOXY (WHITE)

13 NOT USED

- 14 MARKING ARROW EPOXY (TYPE 2)
- 15 MARKING ARROW EPOXY (TYPE 3)
- 16 MARKING ARROW EPOXY (TYPE 5)
- 17 MARKING LINE WET REF EPOXY 10-INCH (WHITE)
- 18 MARKING LINE GROOVED PERMANENT TAPE 6-INCH (WHITE)
- 19 MARKING LINE GROOVED PERMANENT TAPE 10-INCH (WHITE)
- 20 MARKING LINE GROOVED PERMANENT TAPE 6-INCH (DASHED WHITE 12.5 FT LINE 37.5 FT SKIP)
- 21 MARKING LINE GROOVED PERMANENT TAPE 10-INCH (DASHED WHITE 12.5 FT LINE 37.5 FT SKIP)
- 22 MARKING LINE PERMANENT TAPE 6-INCH (DOT PATTERN WHITE 3 FT LINE 9 FT SKIP)

24 NOT USED

- 23 MARKING LINE EPOXY 10-INCH (DOT PATTERN WHITE 3 FT LINE 9 FT SKIP)
- 24 NOT USED
- 25 MARKING CROSSWALK EPOXY TRANSVERSE LINE 6-INCH (DOT PATTERN WHITE 3 FT LINE 9 FT SKIP)
- 26 MARKING LINE EPOXY 6-INCH (DASHED WHITE 12.5 FT LINE 37.5 FT SKIP)
- 27 MARKING LINE GROOVED BLACK EPOXY 6-INCH (DASHED BLACK 12.5 FT LINE 37.5 FT SKIP)
- 28 MARKING LINE GROOVED WET REFLECTIVE EPOXY 10-INCH (WHITE)
- 29 MARKING LINE GROOVED PERMANENT TAPE 10-INCH (DOT PATTERN WHITE 3 FT LINE 9 FT SKIP)

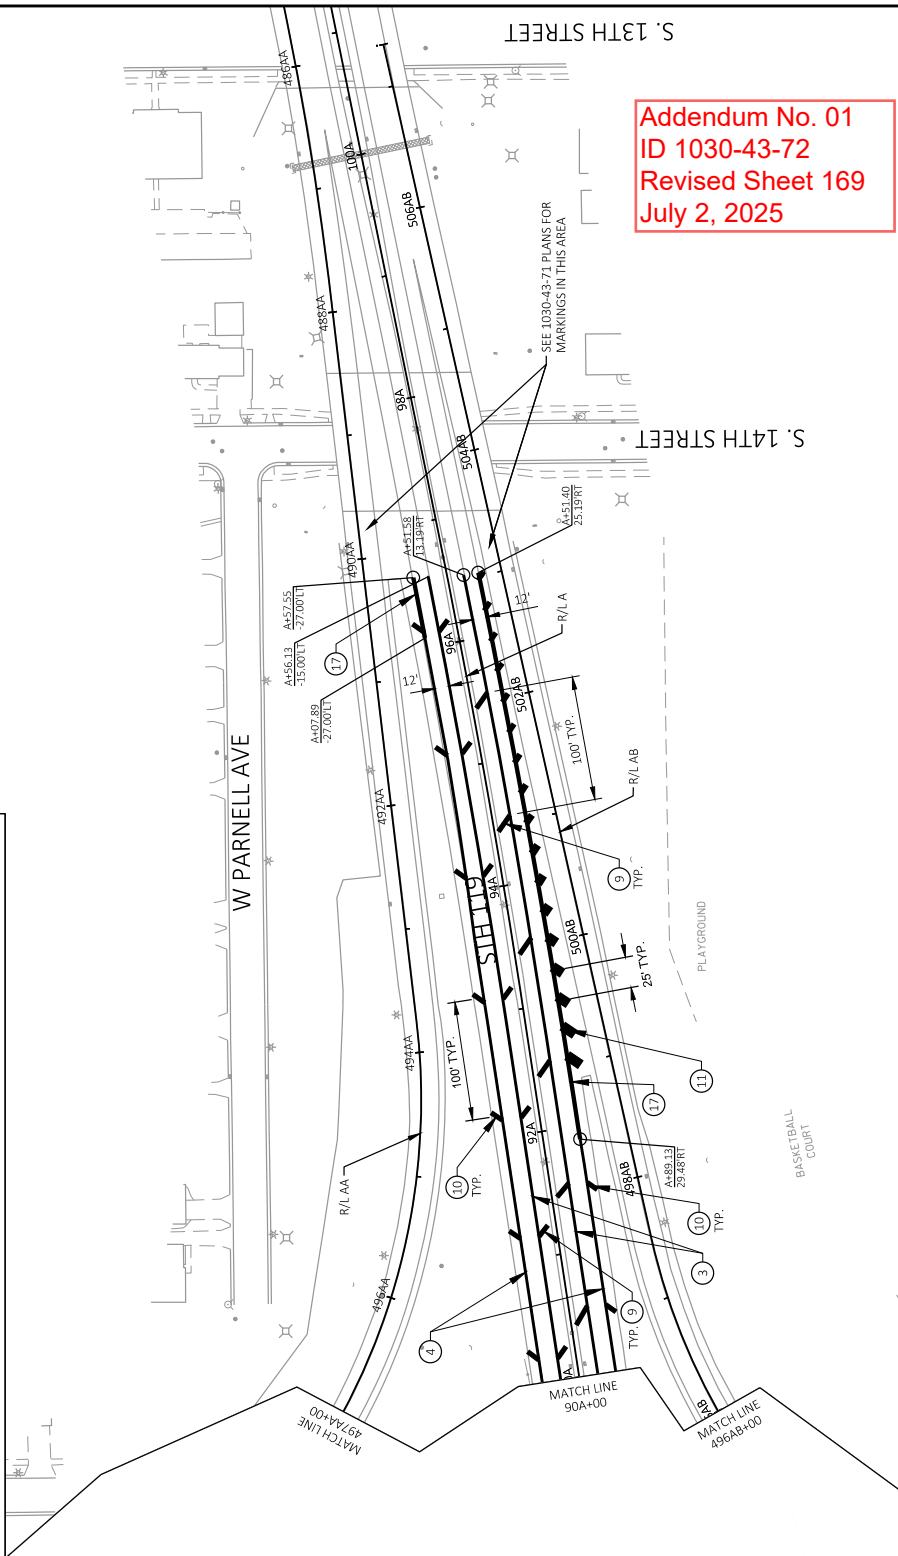

PROJECT NO: 1030-43-72	HWY: IH 41	COUNTY: MILWAUKEE	PAVEMENT MARKING	SHEET 169	E
FILE NAME: X:\BM\3719 MITCHELL INTERCHANGE\DESIGN\03_ROADS\10304372\024501.PAD.DWG					
LAYOUT NAME: 22					
PLOT DATE: 6/24/2025 11:30 PM					
PLOT BY: VALBON LATIFI					
PLOT NAME: 1 IN=100 FT					
WISDOT/CADDS SHEET 42					

3

PROJECT NO: 1030-43-72

Addendum No. 01
ID 1030-43-72
Revised Sheet 355
July 2, 2025

PROJECT NO: 1030-43-72	HWY: IH 41	COUNTY: MILWAUKEE	MISCELLANEOUS QUANTITIES	SHEET: 355
FILE NAME: X:\BIM1-3719 Mitchell Interchange\Design\003_Roads\1030-43-72\Sheets\Plan\03201-mq.dwg			PLOT DATE: 6/25/2025 14:43:23	
			PLOT BY: BLOOM COMPANIES	
			PLOT NAME:	
			PLOT SCALE: 1:1	

PAVEMENT MARKING ITEMS (CONTINUED)

[illegible]

SHEET: 356

PAVEMENT MARKING ITEMS (CONTINUED)

CATEGORY	LOCATION	STATION	TO	STATION																								
					LF	LF	LF	WHITE	WHITE	WHITE	WHITE	WHITE	WHITE	WHITE	WHITE	WHITE	WHITE	WHITE	WHITE	WHITE	WHITE	WHITE	WHITE	WHITE	WHITE	WHITE	WHITE	WHITE
1000	RAMP LG	293TG+06	-	297TG+52	24	100	86	--	--	--	49	--	--	--	--	--	--	--	--	--	--	--	--	--	--	--	--	--
1000	RAMP TH	302TH+00	-	306TH+65	--	123	93	--	--	--	--	--	--	--	--	--	--	--	--	--	--	--	--	--	--	--	--	--
1000	RAMP VN	296VN+66	-	349VN+91	--	2,288	562	461	672	--	--	--	--	--	--	--	--	--	--	--	--	--	--	--	--	--	--	--
1000	RAMP WS	270WS+60	-	327WS+00	--	3,141	473	450	790	733	--	--	--	--	--	--	--	--	--	--	--	--	--	--	--	--	--	--
		327WS+00	-	366WS+64	--	2,092	389	315	386	822	--	--	--	--	--	--	--	--	--	--	--	--	--	--	--	--	--	--
		TOTAL 1000			355	36,210	7,133	11,325	4,118	918	0	0	0	0	0	0	0	0	0	0	0	0	0	0	0	0	0	0
1020	SW PARK AND RIDE	05WPR+66	-	75WPR+19	26	--	--	145	--	--	180	20	2	8,592	874	--	--	--	--	--	--	--	--	--	--	--	--	--
		TOTAL 1020			26	0	0	145	0	180	20	2	2	9,466	--	--	--	--	--	--	--	--	--	--	--	--	--	--
		PROJECT TOTAL			381	36,210	7,133	11,470	4,118	1,098	20	2	2	9,466	170	170	2,710	2,710	65	65	0	0	0	0	0	0	0	0

Addendum No. 01
ID 1030-43-72
Revised Sheet 357
July 2, 2025



Proposal Schedule of Items

Page 1 of 15

Proposal ID: 20250708002 Project(s): 1030-43-71, 1030-43-72

Federal ID(s): WISC 2025547, WISC 2025496

SECTION: 0001

Contract Items

Alt Set ID:

Alt Mbr ID:

Proposal Line Number	Item ID Description	Approximate Quantity and Units	Unit Price	Bid Amount
0002	108.4400 CPM Progress Schedule	2.000 EACH	_____.	_____.
0004	201.0120 Clearing	24.000 ID	_____.	_____.
0006	201.0205 Grubbing	5.000 STA	_____.	_____.
0008	201.0220 Grubbing	24.000 ID	_____.	_____.
0010	203.0220 Removing Structure (structure) 01. R-40-398	1.000 EACH	_____.	_____.
0012	204.0100 Removing Concrete Pavement	50.000 SY	_____.	_____.
0014	204.0115 Removing Asphaltic Surface Butt Joints	13,709.000 SY	_____.	_____.
0016	204.0120 Removing Asphaltic Surface Milling	598,800.000 SY	_____.	_____.
0018	204.0126.S Removing Asphaltic Longitudinal Notched Wedge Joint Milling	85,300.000 LF	_____.	_____.
0020	204.0150 Removing Curb & Gutter	552.000 LF	_____.	_____.
0022	204.0155 Removing Concrete Sidewalk	392.000 SY	_____.	_____.
0024	204.0157 Removing Concrete Barrier	804.000 LF	_____.	_____.
0026	204.9165.S Removing (item description) 01. Removing Porcelain Ceramic Tile Facing	9,505.000 SF	_____.	_____.
0028	205.0100 Excavation Common	1,799.000 CY	_____.	_____.
0030	209.0200.S Backfill Controlled Low Strength	2.000 CY	_____.	_____.



Proposal Schedule of Items

Page 2 of 15

Proposal ID: 20250708002 Project(s): 1030-43-71, 1030-43-72

Federal ID(s): WISC 2025547, WISC 2025496

SECTION: 0001

Contract Items

Alt Set ID:

Alt Mbr ID:

Proposal Line Number	Item ID Description	Approximate Quantity and Units	Unit Price	Bid Amount
0032	210.1500 Backfill Structure Type A	4.000 TON	_____.	_____.
0034	213.0100 Finishing Roadway (project) 01. 1030-43-71	1.000 EACH	_____.	_____.
0036	213.0100 Finishing Roadway (project) 02. 1030-43-72	1.000 EACH	_____.	_____.
0038	305.0110 Base Aggregate Dense 3/4-Inch	370.000 TON	_____.	_____.
0040	305.0120 Base Aggregate Dense 1 1/4-Inch	20.000 TON	_____.	_____.
0042	305.0125 Base Aggregate Dense 1 1/4-Inch	2.000 CY	_____.	_____.
0044	390.0100 Removing Pavement for Base Patching	5,880.000 CY	_____.	_____.
0046	390.0405 Base Patching Concrete SHES	5,880.000 CY	_____.	_____.
0048	416.0610 Drilled Tie Bars	3,817.000 EACH	_____.	_____.
0050	416.0620 Drilled Dowel Bars	19,031.000 EACH	_____.	_____.
0052	416.1715 Concrete Pavement Repair SHES	17.000 SY	_____.	_____.
0054	416.1725 Concrete Pavement Replacement SHES	855.000 SY	_____.	_____.
0056	455.0605 Tack Coat	83,432.000 GAL	_____.	_____.
0058	460.0105.S HMA Percent Within Limits (PWL) Test Strip Volumetrics	2.000 EACH	_____.	_____.
0060	460.0110.S HMA Percent Within Limits (PWL) Test Strip Density	2.000 EACH	_____.	_____.



Proposal Schedule of Items

Page 3 of 15

Proposal ID: 20250708002 Project(s): 1030-43-71, 1030-43-72

Federal ID(s): WISC 2025547, WISC 2025496

SECTION: 0001

Contract Items

Alt Set ID:

Alt Mbr ID:

Proposal Line Number	Item ID Description	Approximate Quantity and Units	Unit Price	Bid Amount
0062	460.0115.S HMA Pavement Test Strip Volumetrics	2.000 EACH	_____.	_____.
0064	460.0120.S HMA Pavement Test Strip Density	2.000 EACH	_____.	_____.
0066	460.2000 Incentive Density HMA Pavement	35,985.000 DOL	1.00000	35,985.00
0068	460.2005 Incentive Density PWL HMA Pavement	34,810.000 DOL	1.00000	34,810.00
0070	460.2007 Incentive Density HMA Pavement Longitudinal Joints	37,550.000 DOL	1.00000	37,550.00
0072	460.2010 Incentive Air Voids HMA Pavement	58,699.000 DOL	1.00000	58,699.00
0074	460.6224 HMA Pavement 4 MT 58-28 S	1,475.000 TON	_____.	_____.
0076	460.7624 HMA Pavement 4 HT 58-28 V	65,385.000 TON	_____.	_____.
0078	460.8624 HMA Pavement 4 SMA 58-28 V	65,588.000 TON	_____.	_____.
0080	460.9000.S Material Transfer Vehicle	1.000 EACH	_____.	_____.
0082	465.0110 Asphaltic Surface Patching	200.000 TON	_____.	_____.
0084	495.1000.S Cold Patch	20.000 TON	_____.	_____.
0086	502.3210 Pigmented Surface Sealer	2.000 SY	_____.	_____.
0088	502.3215 Protective Surface Treatment Reseal	1,058.000 SY	_____.	_____.
0090	502.4204 Adhesive Anchors No. 4 Bar	3.000 EACH	_____.	_____.
0092	504.0500 Concrete Masonry Retaining Walls	1.000 CY	_____.	_____.



Proposal Schedule of Items

Page 4 of 15

Proposal ID: 20250708002 Project(s): 1030-43-71, 1030-43-72

Federal ID(s): WISC 2025547, WISC 2025496

SECTION: 0001

Contract Items

Alt Set ID:

Alt Mbr ID:

Proposal Line Number	Item ID Description	Approximate Quantity and Units	Unit Price	Bid Amount
0094	505.0600 Bar Steel Reinforcement HS Coated Structures	70.000 LB	_____.	_____.
0096	509.1500 Concrete Surface Repair	169.000 SF	_____.	_____.
0098	509.9020.S Epoxy Crack Sealing	35.000 LF	_____.	_____.
0100	513.2001 Railing Pipe	11.000 LF	_____.	_____.
0102	531.2036 Drilling Shaft 36-Inch	10.000 LF	_____.	_____.
0104	531.4050 Foundation Camera Pole 50-FT	1.000 EACH	_____.	_____.
0106	601.0331 Concrete Curb & Gutter 31-Inch	552.000 LF	_____.	_____.
0108	602.0410 Concrete Sidewalk 5-Inch	2,862.000 SF	_____.	_____.
0110	602.0515 Curb Ramp Detectable Warning Field Natural Patina	134.000 SF	_____.	_____.
0112	602.0615 Curb Ramp Detectable Warning Field Radial Natural Patina	41.000 SF	_____.	_____.
0114	602.3010 Concrete Surface Drains	265.000 CY	_____.	_____.
0116	603.1142 Concrete Barrier Type S42	306.000 LF	_____.	_____.
0118	603.1156 Concrete Barrier Type S56	407.000 LF	_____.	_____.
0120	603.8000 Concrete Barrier Temporary Precast Delivered	3,606.000 LF	_____.	_____.
0122	603.8125 Concrete Barrier Temporary Precast Installed	3,606.000 LF	_____.	_____.



Proposal Schedule of Items

Page 5 of 15

Proposal ID: 20250708002 Project(s): 1030-43-71, 1030-43-72

Federal ID(s): WISC 2025547, WISC 2025496

SECTION: 0001

Contract Items

Alt Set ID:

Alt Mbr ID:

Proposal Line Number	Item ID Description	Approximate Quantity and Units	Unit Price	Bid Amount
0124	603.8500 Anchoring Concrete Barrier Temporary Precast	104.000 LF	_____.	_____.
0126	606.0050 Riprap Extra-Light	300.000 CY	_____.	_____.
0128	606.0100 Riprap Light	130.000 CY	_____.	_____.
0130	606.0200 Riprap Medium	2.720 CY	_____.	_____.
0132	608.3012 Storm Sewer Pipe Class III-A 12-Inch	100.000 LF	_____.	_____.
0134	611.0430 Reconstructing Inlets	2.000 EACH	_____.	_____.
0136	611.0654 Inlet Covers Type V	2.000 EACH	_____.	_____.
0138	611.3003 Inlets 3-FT Diameter	2.000 EACH	_____.	_____.
0140	611.8115 Adjusting Inlet Covers	52.000 EACH	_____.	_____.
0142	612.0106 Pipe Underdrain 6-Inch	404.000 LF	_____.	_____.
0144	614.0905 Crash Cushions Temporary	8.000 EACH	_____.	_____.
0146	616.0206 Fence Chain Link 6-FT	887.000 LF	_____.	_____.
0148	616.0329 Gates Chain Link (width) 01. 10-FT	2.000 EACH	_____.	_____.
0150	616.0329 Gates Chain Link (width) 02. 12-FT	1.000 EACH	_____.	_____.
0152	616.0329 Gates Chain Link (width) 03. 22-FT	3.000 EACH	_____.	_____.
0154	616.0410 Fence Chain Link Salvaged 10-FT	390.000 LF	_____.	_____.



Proposal Schedule of Items

Page 6 of 15

Proposal ID: 20250708002 Project(s): 1030-43-71, 1030-43-72

Federal ID(s): WISC 2025547, WISC 2025496

SECTION: 0001

Contract Items

Alt Set ID:

Alt Mbr ID:

Proposal Line Number	Item ID Description	Approximate Quantity and Units	Unit Price	Bid Amount
0156	618.0100 Maintenance and Repair of Haul Roads (project) 01. 1030-43-71	1.000 EACH	_____.	_____.
0158	618.0100 Maintenance and Repair of Haul Roads (project) 02. 1030-43-72	1.000 EACH	_____.	_____.
0160	619.1000 Mobilization	1.000 EACH	_____.	_____.
0162	624.0100 Water	5.000 MGAL	_____.	_____.
0164	625.0100 Topsoil	4,814.000 SY	_____.	_____.
0166	625.0105 Topsoil	100.000 CY	_____.	_____.
0168	628.1504 Silt Fence	750.000 LF	_____.	_____.
0170	628.1520 Silt Fence Maintenance	1,125.000 LF	_____.	_____.
0172	628.1905 Mobilizations Erosion Control	10.000 EACH	_____.	_____.
0174	628.1910 Mobilizations Emergency Erosion Control	4.000 EACH	_____.	_____.
0176	628.2006 Erosion Mat Urban Class I Type A	675.000 SY	_____.	_____.
0178	628.2023 Erosion Mat Class II Type B	9,588.000 SY	_____.	_____.
0180	628.7005 Inlet Protection Type A	10.000 EACH	_____.	_____.
0182	628.7010 Inlet Protection Type B	590.000 EACH	_____.	_____.
0184	628.7020 Inlet Protection Type D	160.000 EACH	_____.	_____.



Proposal Schedule of Items

Page 7 of 15

Proposal ID: 20250708002 Project(s): 1030-43-71, 1030-43-72

Federal ID(s): WISC 2025547, WISC 2025496

SECTION: 0001

Contract Items

Alt Set ID:

Alt Mbr ID:

Proposal Line Number	Item ID Description	Approximate Quantity and Units	Unit Price	Bid Amount
0186	630.0120 Seeding Mixture No. 20	216.000 LB	_____.	_____.
0188	630.0140 Seeding Mixture No. 40	31.000 LB	_____.	_____.
0190	630.0200 Seeding Temporary	230.000 LB	_____.	_____.
0192	630.0500 Seed Water	35.340 MGAL	_____.	_____.
0194	631.0300 Sod Water	6.420 MGAL	_____.	_____.
0196	631.1000 Sod Lawn	285.000 SY	_____.	_____.
0198	633.0500 Delineator Reflectors	20.000 EACH	_____.	_____.
0200	633.1000 Delineators Barrier Wall	20.000 EACH	_____.	_____.
0202	634.0618 Posts Wood 4x6-Inch X 18-FT	24.000 EACH	_____.	_____.
0204	634.0814 Posts Tubular Steel 2x2-Inch X 14-FT	6.000 EACH	_____.	_____.
0206	634.0885 Posts Tubular Steel 2x2-Inch X 8.5-FT	2.000 EACH	_____.	_____.
0208	635.0300 Sign Supports Replacing Base Connection Bolts	1.000 EACH	_____.	_____.
0210	637.1220 Signs Type I Reflective SH	260.000 SF	_____.	_____.
0212	637.2210 Signs Type II Reflective H	216.710 SF	_____.	_____.
0214	637.2230 Signs Type II Reflective F	80.000 SF	_____.	_____.
0216	638.2102 Moving Signs Type II	6.000 EACH	_____.	_____.



Proposal Schedule of Items

Page 8 of 15

Proposal ID: 20250708002 Project(s): 1030-43-71, 1030-43-72

Federal ID(s): WISC 2025547, WISC 2025496

SECTION: 0001

Contract Items

Alt Set ID:

Alt Mbr ID:

Proposal Line Number	Item ID Description	Approximate Quantity and Units	Unit Price	Bid Amount
0218	638.2602 Removing Signs Type II	25.000 EACH	_____.	_____.
0220	638.3000 Removing Small Sign Supports	24.000 EACH	_____.	_____.
0222	643.0300 Traffic Control Drums	213,429.000 DAY	_____.	_____.
0224	643.0420 Traffic Control Barricades Type III	20,553.000 DAY	_____.	_____.
0226	643.0705 Traffic Control Warning Lights Type A	41,105.000 DAY	_____.	_____.
0228	643.0715 Traffic Control Warning Lights Type C	45,802.000 DAY	_____.	_____.
0230	643.0810.S Connected Arrow Board	2,023.000 DAY	_____.	_____.
0232	643.0900 Traffic Control Signs	67,334.000 DAY	_____.	_____.
0234	643.0910 Traffic Control Covering Signs Type I	125.000 EACH	_____.	_____.
0236	643.0920 Traffic Control Covering Signs Type II	550.000 EACH	_____.	_____.
0238	643.1000 Traffic Control Signs Fixed Message	806.000 SF	_____.	_____.
0240	643.1050 Traffic Control Signs PCMS	1,394.000 DAY	_____.	_____.
0242	643.1205.S Basic Traffic Queue Warning System	262.000 DAY	_____.	_____.
0244	643.1220.S Connected Work Zone Start and End Location Markers	385.000 DAY	_____.	_____.
0246	643.3120 Temporary Marking Line Epoxy 4-Inch	200.000 LF	_____.	_____.
0248	643.3170 Temporary Marking Line Epoxy 6-Inch	553,250.000 LF	_____.	_____.



Proposal Schedule of Items

Page 9 of 15

Proposal ID: 20250708002 Project(s): 1030-43-71, 1030-43-72

Federal ID(s): WISC 2025547, WISC 2025496

SECTION: 0001

Contract Items

Alt Set ID:

Alt Mbr ID:

Proposal Line Number	Item ID Description	Approximate Quantity and Units	Unit Price	Bid Amount
0250	643.3270 Temporary Marking Line Epoxy 10-Inch	117,360.000 LF	_____.	_____.
0252	643.4100 Traffic Control Interim Lane Closure	655.000 EACH	_____.	_____.
0254	643.5000 Traffic Control	1.000 EACH	_____.	_____.
0256	644.1430 Temporary Pedestrian Surface Plate	640.000 SF	_____.	_____.
0258	644.1601 Temporary Pedestrian Curb Ramp	44.000 DAY	_____.	_____.
0260	644.1605 Temporary Pedestrian Detectable Warning Field	24.000 SF	_____.	_____.
0262	644.1810 Temporary Pedestrian Barricade	542.000 LF	_____.	_____.
0264	644.1900.S Temporary Audible Message Devices	286.000 DAY	_____.	_____.
0266	645.0130 Geotextile Type R	3,491.000 SY	_____.	_____.
0268	646.1050 Marking Line Grooved Permanent Tape 4-Inch	100.000 LF	_____.	_____.
0270	646.2020 Marking Line Epoxy 6-Inch	68,916.000 LF	_____.	_____.
0272	646.2025 Marking Line Grooved Black Epoxy 6-Inch	42,037.000 LF	_____.	_____.
0274	646.2040 Marking Line Grooved Wet Ref Epoxy 6-Inch	165,434.000 LF	_____.	_____.
0276	646.2050 Marking Line Grooved Permanent Tape 6-Inch	42,179.000 LF	_____.	_____.
0278	646.3020 Marking Line Epoxy 8-Inch	152.000 LF	_____.	_____.



Proposal Schedule of Items

Page 10 of 15

Proposal ID: 20250708002 Project(s): 1030-43-71, 1030-43-72

Federal ID(s): WISC 2025547, WISC 2025496

SECTION: 0001

Contract Items

Alt Set ID:

Alt Mbr ID:

Proposal Line Number	Item ID Description	Approximate Quantity and Units	Unit Price	Bid Amount
0280	646.4020 Marking Line Epoxy 10-Inch	7,044.000 LF	_____.	_____.
0282	646.4025 Marking Line Grooved Black Epoxy 10-Inch	5,800.000 LF	_____.	_____.
0284	646.4040 Marking Line Grooved Wet Ref Epoxy 10-Inch	42,342.000 LF	_____.	_____.
0286	646.4050 Marking Line Grooved Permanent Tape 10-Inch	7,238.000 LF	_____.	_____.
0288	646.5020 Marking Arrow Epoxy	83.000 EACH	_____.	_____.
0290	646.5120 Marking Word Epoxy	44.000 EACH	_____.	_____.
0292	646.5220 Marking Symbol Epoxy	8.000 EACH	_____.	_____.
0294	646.6120 Marking Stop Line Epoxy 18-Inch	739.000 LF	_____.	_____.
0296	646.6220 Marking Yield Line Epoxy 18-Inch	9.000 EACH	_____.	_____.
0298	646.6464 Cold Weather Marking Epoxy 4-Inch	100.000 LF	_____.	_____.
0300	646.6466 Cold Weather Marking Epoxy 6-Inch	64,006.000 LF	_____.	_____.
0302	646.6470 Cold Weather Marking Epoxy 10-Inch	12,896.000 LF	_____.	_____.
0304	646.7120 Marking Diagonal Epoxy 12-Inch	20,858.000 LF	_____.	_____.
0306	646.7220 Marking Chevron Epoxy 24-Inch	8,113.000 LF	_____.	_____.
0308	646.7420 Marking Crosswalk Epoxy Transverse Line 6-Inch	1,685.000 LF	_____.	_____.



Proposal Schedule of Items

Page 11 of 15

Proposal ID: 20250708002 Project(s): 1030-43-71, 1030-43-72

Federal ID(s): WISC 2025547, WISC 2025496

SECTION: 0001

Contract Items

Alt Set ID:

Alt Mbr ID:

Proposal Line Number	Item ID Description	Approximate Quantity and Units	Unit Price	Bid Amount
0310	646.8120 Marking Curb Epoxy	20.000 LF	_____.	_____.
0312	646.8220 Marking Island Nose Epoxy	2.000 EACH	_____.	_____.
0314	646.8320 Marking Parking Stall Epoxy	9,466.000 LF	_____.	_____.
0316	646.9165 Marking Removal Line Grooved Contrast Permanent Tape 10-Inch	511.000 LF	_____.	_____.
0318	652.0110 Conduit Rigid Metallic 1-Inch	35.000 LF	_____.	_____.
0320	652.0210 Conduit Rigid Nonmetallic Schedule 40 1-Inch	35.000 LF	_____.	_____.
0322	652.0225 Conduit Rigid Nonmetallic Schedule 40 2-Inch	62.000 LF	_____.	_____.
0324	652.0700.S Install Conduit into Existing Item	2.000 EACH	_____.	_____.
0326	655.0515 Electrical Wire Traffic Signals 10 AWG	55.000 LF	_____.	_____.
0328	670.0101 Field System Integrator	1.000 EACH	_____.	_____.
0330	670.0201 ITS Documentation	1.000 EACH	_____.	_____.
0332	677.0150 Install Camera Pole 50-FT	1.000 EACH	_____.	_____.
0334	677.0200 Install Camera Assembly	2.000 EACH	_____.	_____.
0336	690.0150 Sawing Asphalt	1,000.000 LF	_____.	_____.
0338	690.0250 Sawing Concrete	49,271.000 LF	_____.	_____.



Proposal Schedule of Items

Page 12 of 15

Proposal ID: 20250708002 Project(s): 1030-43-71, 1030-43-72

Federal ID(s): WISC 2025547, WISC 2025496

SECTION: 0001

Contract Items

Alt Set ID:

Alt Mbr ID:

Proposal Line Number	Item ID Description	Approximate Quantity and Units	Unit Price	Bid Amount
0340	715.0603 Incentive Strength Concrete Barrier	426.500 DOL	1.00000	426.50
0342	740.0440 Incentive IRI Ride	116,000.000 DOL	1.00000	116,000.00
0344	ASP.1T0A On-the-Job Training Apprentice at \$5.00/HR	7,000.000 HRS	5.00000	35,000.00
0346	ASP.1T0G On-the-Job Training Graduate at \$5.00/HR	17,280.000 HRS	5.00000	86,400.00
0348	SPV.0030 Special 01. Fertilizer Type B, Special	3.470 CWT	_____.	_____.
0350	SPV.0035 Special 01. Gabions	11.000 CY	_____.	_____.
0352	SPV.0060 Special 05. Mobilizations Emergency Pavement Repair	8.000 EACH	_____.	_____.
0354	SPV.0060 Special 06. Traffic Control Close-Open Freeway Entrance Ramp	386.000 EACH	_____.	_____.
0356	SPV.0060 Special 07. Traffic Control Close-Open Freeway to Freeway System Ramp	198.000 EACH	_____.	_____.
0358	SPV.0060 Special 08. Traffic Control Full Freeway Closure	121.000 EACH	_____.	_____.
0360	SPV.0060 Special 10. Traffic Control Local Road Lane Closures	10.000 EACH	_____.	_____.
0362	SPV.0060 Special 11. Survey Project 1030-43-71	1.000 EACH	_____.	_____.
0364	SPV.0060 Special 13. Survey Project 1030-43-72	1.000 EACH	_____.	_____.
0366	SPV.0060 Special 21. Remove Ground Mount DMS	1.000 EACH	_____.	_____.



Proposal Schedule of Items

Page 13 of 15

Proposal ID: 20250708002 Project(s): 1030-43-71, 1030-43-72

Federal ID(s): WISC 2025547, WISC 2025496

SECTION: 0001

Contract Items

Alt Set ID:

Alt Mbr ID:

Proposal Line Number	Item ID Description	Approximate Quantity and Units	Unit Price	Bid Amount
0368	SPV.0060 Special 22. Install Ground Mount DMS	1.000 EACH	_____.	_____.
0370	SPV.0060 Special 23. Ground Rod	1.000 EACH	_____.	_____.
0372	SPV.0060 Special 24. Emergency Response to Traffic Involving Crash Cushion	10.000 EACH	_____.	_____.
0374	SPV.0060 Special 25. Emergency Response to Traffic Involving Concrete Barrier Temporary	10.000 EACH	_____.	_____.
0376	SPV.0060 Special 41. Anchor Slab Repair at Inlet	11.000 EACH	_____.	_____.
0378	SPV.0060 Special 42. Precast Concrete Wall Panel Repair R-40-382	1.000 EACH	_____.	_____.
0380	SPV.0060 Special 43. Precast Concrete Wall Panel Repair R-40-417	1.000 EACH	_____.	_____.
0382	SPV.0060 Special 44. Precast Concrete Wall Panel Repair R-40-439	1.000 EACH	_____.	_____.
0384	SPV.0075 Special 01. Pavement Cleanup	200.000 HRS	_____.	_____.
0386	SPV.0085 Special 01. Foam-Jacking	18,477.000 LB	_____.	_____.
0388	SPV.0085 Special 02. Sealing Cracks and Joints with Hot Applied Sealant	1,667.000 LB	_____.	_____.
0390	SPV.0090 Special 01. Marking Line Permanent Tape 6-Inch	96.000 LF	_____.	_____.
0392	SPV.0090 Special 02. Sealing Parapet Joint	173.000 LF	_____.	_____.
0396	SPV.0090 Special 05. Marking Line Wet Reflective Epoxy 10-Inch	4,545.000 LF	_____.	_____.



Proposal Schedule of Items

Page 14 of 15

Proposal ID: 20250708002 Project(s): 1030-43-71, 1030-43-72

Federal ID(s): WISC 2025547, WISC 2025496

SECTION: 0001

Contract Items

Alt Set ID:

Alt Mbr ID:

Proposal Line Number	Item ID Description	Approximate Quantity and Units	Unit Price	Bid Amount
0398	SPV.0090 Special 06. Clean and Reseal Joint	1,403.000 LF	_____.	_____.
0400	SPV.0090 Special 07. Linear Delineation System	65.000 LF	_____.	_____.
0402	SPV.0090 Special 08. Concrete Barrier Dual Pan 32-Inch	75.000 LF	_____.	_____.
0404	SPV.0090 Special 09. Concrete Barrier 42-Inch Vertical Back	65.000 LF	_____.	_____.
0406	SPV.0090 Special 10. Concrete Curb and Gutter 4-Inch Sloped 60-Inch Type A	16.000 LF	_____.	_____.
0408	SPV.0090 Special 41. Sealing Precast Concrete Wall Facing Unit Joint	460.000 LF	_____.	_____.
0410	SPV.0135 Special 01. Field Office	18.000 MON	_____.	_____.
0412	SPV.0165 Special 01. Tied Concrete Block Mat with Doubled Layered Underlayment	1,700.000 SF	_____.	_____.
0414	SPV.0165 Special 41. Anchor Slab Surface Repair	84.000 SF	_____.	_____.
0416	SPV.0165 Special 42. Concrete Restaining	2,233.000 SF	_____.	_____.
0418	SPV.0180 Special 01. Resin Binder High Friction Surface Treatment	73,478.000 SY	_____.	_____.
0420	SPV.0180 Special 02. Expansion Joint Repair Rapid Set	786.000 SY	_____.	_____.
0422	SPV.0180 Special 03. Concrete Pavement Approach Slab Repair Rapid Set	838.000 SY	_____.	_____.
0424	SPV.0180 Special 04. Removing High Friction Surface Treatment	2,190.000 SY	_____.	_____.



Proposal Schedule of Items

Page 15 of 15

Proposal ID: 20250708002 Project(s): 1030-43-71, 1030-43-72

Federal ID(s): WISC 2025547, WISC 2025496

SECTION: 0001

Contract Items

Alt Set ID:

Alt Mbr ID:

Proposal Line Number	Item ID Description	Approximate Quantity and Units	Unit Price	Bid Amount
0426	SPV.0180 Special 05. Asphalt Wedge	209.000 SY	_____.	_____.
0428	SPV.0180 Special 07. Concrete Pavement Repair Rapid Set	98.000 SY	_____.	_____.
0430	SPV.0195 Special 01. Joint and Crack Repair	800.000 TON	_____.	_____.
0432	646.9200 Marking Removal Line Wide	340.000 LF	_____.	_____.
Section: 0001			Total:	_____.
			Total Bid:	_____.

